


STATE OF KANSAS
STATE CORPORATION COMMISSION

WELL PLUGGING RECORD

Give All Information Completely
Make Required Affidavit
Mail or Deliver Report to:
Conservation Division
State Corporation Commission
800 Biting Building
Wichita, Kansas

Kingman County. Sec. 30 Twp. 27S Rge. 7W (E) (W) W

Location as "NE/CNW/SW" or footage from lines NW NW SE
Lease Owner. ~~XXXXXXXXXX~~ Fred B. Anschutz
Lease Name City of Kingman Well No. 1
Office Address 709 Union Nat'l Bk Bldg, Wichita, Kansas
Character of Well (completed as Oil, Gas or Dry Hole) Dry Hole
Date well completed July 29, 19 55
Application for plugging filed July 29, 19 55
Application for plugging approved July 29, 19 55
Plugging commenced July 29, 19 55
Plugging completed July 29, 19 55
Reason for abandonment of well or producing formation Dry hole

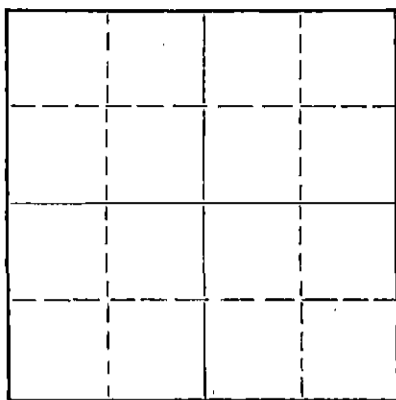

Locate well correctly on above
Section Plat

If a producing well is abandoned, date of last production 19
Was permission obtained from the Conservation Division or its agents before plugging was com-
menced? Yes

Name of Conservation Agent who supervised plugging of this well Rud Durkee, McPherson, Kansas
Producing formation _____ Depth to top _____ Bottom _____ Total Depth of Well 4460 Feet
Show depth and thickness of all water, oil and gas formations.

OIL, GAS OR WATER RECORDS

CASING RECORD

FORMATION	CONTENT	FROM	TO	SIZE	PUT IN	PULLED OUT
				8 5/8"	207'	None

Describe in detail the manner in which the well was plugged, indicating where the mud fluid was placed and the method or methods used in introducing it into the hole. If cement or other plugs were used, state the character of same and depth placed, from _____ feet to _____ feet for each plug set.

Bottom Plug set at 200 feet with 200 sacks cement
Top Plug set at 35 feet with 10 sacks cement

RECEIVED
STATE CORPORATION COMMISSION

AUG 4 X 1955

8-4355

CONSERVATION DIVISION

(If additional description is necessary, use BACK of this sheet)
Name of Plugging Contractor Anschutz Drilling Co., Inc.
Address 709 Union Nat'l Bk Bldg, Wichita, Kansas

STATE OF Kansas, COUNTY OF Sedgwick, ss.
J. J. Schaplowsky (employee of owner) or (owner or operator) of the above-described well, being first duly sworn on oath, says: That I have knowledge of the facts, statements, and matters herein contained and the log of the above-described well as filed and that the same are true and correct. So help me God.

(Signature) J. J. Schaplowsky
709 Union Nat'l Bk Bldg, Wichita, Kansas
(Address)

SUBSCRIBED AND SWORN TO before me this 3rd day of August, 19 55

My commission expires Nov. 10, 1958

L. Alice Woodruff
Notary Public.

PLUGGING
FILE DEC 30 T 27S 7W
BOOK PAGE 29 LINE 11

D R I L L E R ' S L O G

Fred B. Anschutz
#1 City of Kingman
NW NW SE 30-27S-7W

Kingman County, Kansas

<u>FROM</u>	<u>TO</u>	
0	50	Sand
50	215	Red Bed
209	215	Cement
215	395	Shale, Salt & Shells
395	405	Anhydrite
405	980	Shale & shells
980	1040	Salt
1040	1110	Ft. Riley
1110	1330	Lime
1330	1480	Shale, Lime & Shells
1480	1750	Shale & Lime
1750	2130	Lime & Shale
2130	2315	Shale & shells
2315	2410	Lime & Shale
2410	2790	Shale & Shells
2790	3248	Lime and shale
3248	3280	Brown Lime
3280	3875	Lime
3875	3956	Shale & Lime
3956	3970	Mississippi Chat
3970	3990	Mississippian
3990	4105	Mississippian lime
4105	4160	Lime & Shale
4160	4225	Lime & Shale
4225	4290	Shale, Lime & Chert
4290	4325	Shale & Lime
4325	4337	Lime
4337	4388	Lime, Chert, Shale
4388	4460	Lime & Shale
	4460	ROTARY TOTAL DEPTH

COMMENCED: 7-13-55
COMPLETED: 7-29-55

CASING RECORD:

Set 207' of 8 5/8" surface casing with 150 sacks cement

STATE OF KANSAS)
) SS
COUNTY OF SEDGWICK)

I hereby affirm that the above and foregoing is a true and correct copy of the log of the No. 1 City of Kingman located NW NW SE of Section 30-27S-7W, Kingman County, Kansas.

ON COMMISSION OF ANSCHUTZ DRILLING CO., INC.

8-4-55

CONSERVATION DIVISION
STATE OF KANSAS

By: *J. J. Schaplowsky*
J. J. Schaplowsky
Treasurer

Subscribed and sworn to before me this 3rd day of August, 1955.

L. Alice Woodruff
Notary Public
L. Alice Woodruff

My Commission Expires: November 10, 1958

PLUGGING
FILE SEC 30 T 27 R 7W
BOOK PAGE 139 LINE 11