


WELL PLUGGING RECORD

Give All Information Completely
Make Required Affidavit
Mail or Deliver Report to:
Conservation Division
State Corporation Commission
212 North Market, Insurance Bldg.
Wichita, Kansas

KINGMAN County. Sec. 29 Twp. 27 Rge. 7 (E) W (W)
Location as "NE/CNWxSWx" or footage from lines C SE NE
Lease Owner IMPERIAL OIL OF KANSAS, INC.
Lease Name VAN SICKLE CORE HOLE Well No. 145
Office Address 780 FOURTH NATL. BLDG. WICHITA, KANSAS
Character of Well (completed as Oil, Gas or Dry Hole) DRY HOLE
Date well completed APRIL 3 19 63
Application for plugging filed APRIL 3 19 63
Application for plugging approved APRIL 3 19 63
Plugging commenced APRIL 3 19 63
Plugging completed APRIL 3 19 63
Reason for abandonment of well or producing formation DRY HOLE

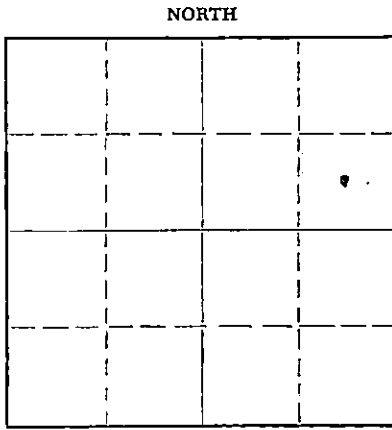

Locate well correctly on above Section Plat

If a producing well is abandoned, date of last production 19
Was permission obtained from the Conservation Division or its agents before plugging was commenced? YES

Name of Conservation Agent who supervised plugging of this well ARCHIE ELVING, PRATT, KANSAS
Producing formation _____ Depth to top _____ Bottom _____ Total Depth of Well 1415 Feet
Show depth and thickness of all water, oil and gas formations.

OIL, GAS OR WATER RECORDS

CASING RECORD

FORMATION	CONTENT	FROM	TO	SIZE	PUT IN	PULLED OUT

Describe in detail the manner in which the well was plugged, indicating where the mud fluid was placed and the method or methods used in introducing it into the hole. If cement or other plugs were used, state the character of same and depth placed, from _____ feet to _____ feet for each plug set.

BOTTOM PLUG @ 240' w/25 SACKS CEMENT
TOP PLUG @ 40' w/15 SACKS CEMENT

5-20-63

MAY 20 1963

(If additional description is necessary, use BACK of this sheet)
Name of Plugging Contractor CHEMICAL & TECHNICAL SERVICES, INC.
Address BOX D, HILL CITY, KANSAS

STATE OF KANSAS, COUNTY OF GRAHAM, ss.
DANIEL F. MCCARTHY (employee of ~~owner~~ ~~owner~~ or operator) of the above-described well, being first duly sworn on oath, says: That I have knowledge of the facts, statements, and matters herein contained and the log of the above-described well as filed and that the same are true and correct. So help me God.

(Signature) Daniel F. McCarthy
BOX D, HILL CITY, KANSAS
(Address)

SUBSCRIBED AND SWORN TO before me this 19th day of April, 19 63

My commission expires January 23, 1964
Notary Public.



15-095-19121-0000

DRILLER'S LOG

IMPERIAL OIL OF KANSAS, INC.
780 FOURTH NATIONAL BUILDING
WICHITA 2, KANSAS

CORE HOLE NO. VAN SICKLE CORE HOLE #145
C SE NE SEC. 29-27-7W
KINGMAN CO., KANSAS

TOTAL DEPTH: 1415

ELEVATION:

COMMENCED: 4/1/63 COMPLETED: 4/3/63

CONTRACTOR: CHEM-TECH -- BOX 728
HILL CITY, KANSAS

ALL TOPS AND BOTTOMS OF THE FORMATIONS ARE CONFIDENTIAL INFORMATION OF THE GEOLOGICAL DEPARTMENT OF IMPERIAL OIL OF KANSAS, INC.
780 FOURTH NATIONAL BUILDING
WICHITA 2, KANSAS

WE HEREBY CERTIFY THIS TO BE A CORRECT AND ACCURATE LOG OF THE ABOVE DESCRIBED WELL, AS SHOWN ON THE DAILY DRILLING REPORTS.

CHEMICAL & TECHNICAL SERVICES, INC.

BY: D. J. McCarthy
ASSISTANT TREASURER

SUBSCRIBED AND SWORN TO BEFORE ME THIS 19th DAY OF April, 1963.

MY COMMISSION EXPIRES:

My Commission Expires January 23, 1964

Don Miller
NOTARY PUBLIC

MAY 20 1963
5-20-63
COMM. EXPIRES JAN 23 1964