

Give All Information Completely
Make Required Affidavit
Mail or Deliver Report to:
Conservation Division
State Corporation Commission
211 No. Broadway
Wichita, Kansas

WELL PLUGGING RECORD

Kingman County, Sec. 29 Twp. 27S Rge. 7 ~~(X)~~ W (W)

Location as "NE/CNW/SW" or footage from lines C SW NE

Lease Owner Mack Oil Company

Lease Name Van Sickle Well No. 1

Office Address 812 Union Center Building, Wichita, Kansas 67202

Character of Well (completed as Oil, Gas or Dry Hole) Dry Hole

Date well completed June 21 19 66

Application for plugging filed June 21 19 66

Application for plugging approved June 21 19 66


Plugging commenced June 21 19 66

Plugging completed June 21-11:45 pm 19 66

Reason for abandonment of well or producing formation Dry

If a producing well is abandoned, date of last production _____ 19 _____

Was permission obtained from the Conservation Division or its agents before plugging was commenced? Yes

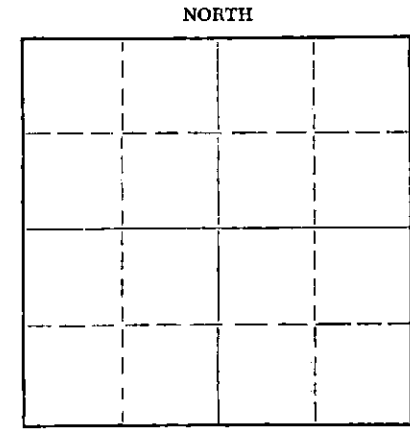

Name of Conservation Agent who supervised plugging of this well Archie Elving, Pratt, Kansas

Producing formation None Depth to top _____ Bottom _____ Total Depth of Well 4360 Feet

Show depth and thickness of all water, oil and gas formations.

OIL, GAS OR WATER RECORDS

CASING RECORD

FORMATION	CONTENT	FROM	TO	SIZE	PUT IN	PULLED OUT

Describe in detail the manner in which the well was plugged, indicating where the mud fluid was placed and the method or methods used in introducing it into the hole. If cement or other plugs were used, state the character of same and depth placed, from _____ feet to _____ feet for each plug set.

Plugged with 30 sax common cement @ 250'
25 sax common cement @ 50'
5 sax common cement @ rathole & mousehole
Plug down at 11:45 p. m., June 21, 1966

RECEIVED
STATE CORPORATION COMMISSION

JUN 24 1966

6-24-66

CONSERVATION DIVISION
WICHITA, KANSAS

(If additional description is necessary, use BACK of this sheet)

Name of Plugging Contractor Mack Oil Company

Address P. O. Box 400, Duncan, Oklahoma 73533

STATE OF KANSAS, COUNTY OF SEDGWICK, ss.

Robert L. Harris (employee of owner) or (owner or operator) of the above-described well, being first duly sworn on oath, says: That I have knowledge of the facts, statements, and matters herein contained and the log of the above-described well as filed and that the same are true and correct. So help me God.

(Signature) Robert L. Harris

812 Union Center Bldg., Wichita, Kansas 67202
(Address)

SUBSCRIBED AND SWORN TO before me this 24th day of June, 19 66

Elizabeth F. Nice
Elizabeth F. Nice
Notary Public.

My commission expires September 21, 1968

15-095-30075-0000

MACK OIL COMPANY
Duncan, Oklahoma

DRILLERS WELL LOG

#1 Van Sickle

C SW NE - Section 29-27S-7W

Kingman County, Kansas

Commenced R. D.: 6- 9-66

Elevation: 1600' Kelly Bushing

Completed R. D.: 6-20-66

Initial Production: Dry

Rotary Total Depth: 4360'

Contractor: Mack Oil Company

<u>STRATA</u>	<u>DEPTH</u>
Top Soil & Sand	0 - 40'
Red Rock	40 - 155
Shale	155 - 255
Shale & Red Bed	255 - 350
Shale	350 - 1110
Anhydrite & Shale	1110 - 1370
Lime & Shale	1370 - 2070
Lime	2070 - 2095
Lime & Shale	2095 - 3037
Lime	3037 - 3220
Lime & Shale	3220 - 3311
Lime	3311 - 3807
Lime & Shale	3807 - 3915
Lime	3915 - 4020
Miss. Chert	4020 - 4069
Lime	4069 - 4221
Lime & Shale	4221 - 4325
Lime	4325 - 4360'

I hereby certify that the above is a true and correct log of said well as reflected by the daily drilling reports.

MACK OIL COMPANY

By Robert L. Harris
Robert L. Harris

Signed and sworn to in my presence this 24th day of June, 1966, by Robert L. Harris, representative of Mack Oil Company.

Elizabeth F. Nice
Elizabeth F. Nice, Notary Public

My Commission Expires September 21, 1968

RECEIVED
STATE CORPORATION COMMISSION

JUN 24 1966

6-24-66

CONSERVATION DIVISION
Topeka, Kansas