


Give All Information Completely
Make Required Affidavit
Mail or Deliver Report to:
Conservation Division
State Corporation Commission
800 Bittling Building
Wichita, Kansas

OR

FORMATION PLUGGING RECORD

Strike out upper line
when reporting plug-
ging off formations.

NORTH

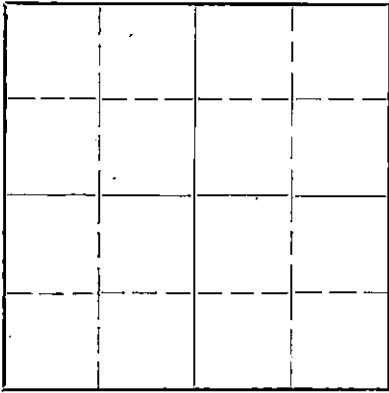

Locate well correctly on above
Section Plat

Kingman County. Sec. 28 Twp. 27 Rge. 7W (E) (W)

Location as "NE $\frac{1}{4}$ NW $\frac{1}{4}$ SW $\frac{1}{4}$ " or footage from lines Nw. corner SE $\frac{1}{4}$

Lease Owner Falcon-Seaboard Drilling Company

Lease Name A. Gerber Well No. 1

Office Address Wichita, Kansas

Character of Well (completed as Oil, Gas or Dry Hole) Dry Hole

Date well completed December 30th 1943

Application for plugging filed December 30th 1943

Application for plugging approved December 30th 1943

Plugging commenced December 30th 1943

Plugging completed December 30th 1943

Reason for abandonment of well or producing formation Dry Hole

If a producing well is abandoned, date of last production 19

Was permission obtained from the Conservation Division or its agents before plugging was commenced? Yes

Name of Conservation Agent who supervised plugging of this well Mr. Duerke, McPherson, Kansas

Producing formation Depth to top Bottom Total Depth of Well 4440' Feet

Show depth and thickness of all water, oil and gas formations.

OIL, GAS OR WATER RECORDS

CASING RECORD

Formation	Content	From	To	Size	Put In	Pulled Out
Sand	Dry	65'	75'	10 3/4"	158'	None

Describe in detail the manner in which the well was plugged, indicating where the mud fluid was placed and the method or methods used in introducing it into the hold. If cement or other plugs were used, state the character of same and depth placed, from feet to feet for each plug set.

Well plugged with heavy mud from 4440' to 158'
Permanent plug placed at 158' and cemented with 20 sacks of
cement from 158' to 118'. Heavy mud from 118' to 26'. Per-
manent plug placed at 26' and cemented with 10 sacks of
cement from 26' to 6'.

28 17 7W
104 11

(If additional description is necessary, use BACK of this sheet)

Correspondence regarding this well should be addressed to Falcon Seaboard Drilling Company,
Address Union National Bank Building, Wichita, Kansas

STATE OF Kansas, COUNTY OF Sedgwick, ss. 1-14-44
Jim Adkins (employee of owner) or (owner or operator) of the above-described well,

being first duly sworn on oath, says: That I have knowledge of the facts, statements, and matters herein contained and the log of the above-described well as filed and that the same are true and correct. So help me God.

(Signature) Jim Adkins
1502- 12th, Great Bend, Kansas
(Address)

SUBSCRIBED AND SWORN to before me this 12th day of January, 1944

My commission expires April 7, 1947

Margaret O'Leilly
Notary Public

Sec. 28, T. 27, Rge. 7-W.
Kingman, County, Kansas.

Started rigging up 11-27-43
Tearing out rotary 12-30-43

Ran 4 jts. 160' 10 3/4" casing
set at 158' with 100' cement,
12-8-43
Finished laying down 4 1/2" drill
pipe. Plugged hole w/ 40 sacks
cement - 12-30-43

<u>FORMATION</u>	<u>FROM</u>	<u>TO</u>	<u>REMARKS</u>
Surface clay & Sand	0	20	
Red bed	20	55	
Sand	55	75	
Red bed	75	115	
Shale	115	300	Slope test 250' OK
Shale and shells	300	350	
Salt	350	1060	
Shale and shells	1060	1100	
Shale	1100	1105	
Lime	1105	1110	
Lime and shale	1110	1210	Slope test 1200' OK
Lime	1210	1245	
Lime and shale	1245	1375	
Broken lime and shale	1375	1485	
Lime and shale	1485	1520	Slope test 1500' OK
Lime	1520	1735	
Lime and shale	1735	2425	Slope test 2000' OK
Lime	2425	2430	
Lime and shale	2430	2565	
Broken lime	2565	2610	
Broken lime & Shale	2610	2705	
Lime	2705	2950	Slope test 2750' OK
Lime and shale	2950	3010	Slope test 3000' OK
Sandy lime	3010	3190	
Shale and lime	3190	3242	
Lime	3242	3435	
Shale and lime	3435	3460	
Lime	3460	3480	
Shale and lime	3480	3502	Slope test 3500' OK
Chalky lime	3502	3512	
Lime	3512	3675	
Lime and shale	3675	3835	
Shale and shells	3835	3885	
Shale	3885	3945	
Lime and shale	3945	3982	
Lime	3982	3970	
Chat	3970	4050	
Lime and shale	4050	4060	
Lime	4060	4080	
Cherty lime	4080	4100	
Shale	4100	4110	
Shale and lime	4110	4135	
Shale	4135	4270	
Shale and sand	4270	4388	
Lime (arabuckie)	4388	4405	
Lime	4405	4440	Total depth

28 17 74
104

1-14-44

I, W. A. Grant, partner of Harbor Drilling Company, certify that to the best of my knowledge and belief, the above log is true and correct.

Subscribed and sworn to before me
this 10th day of January, 1944.
My commission expires April 7, 1947

W. A. Grant

Margaret O'Reilly
Notary Public