


WELL PLUGGING RECORD

Give All Information Completely  
Make Required Affidavit  
Mail or Deliver Report to:  
Conservation Division  
State Corporation Commission  
212 No. Market  
Wichita, Kansas

NORTH

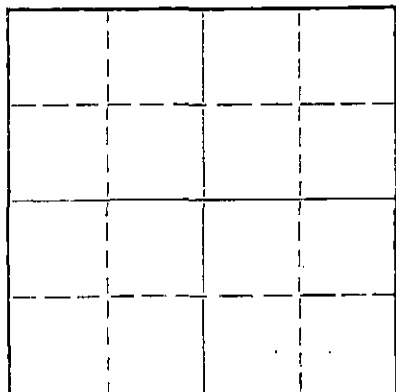

Locate well correctly on above  
Section Plat

Location as "NE/CNW/SW" or footage from lines Kingman County. Sec. 27 Twp. 27S Rge. 7 ~~X000~~ (W) West  
Lease Owner MACK OIL CO.  
Lease Name Margaret Well No. 1  
Office Address 812 Union Center Building, Wichita, Kansas 67202  
Character of Well (completed as Oil, Gas or Dry Hole) Dry Hole  
Date well completed November 6 19 66  
Application for plugging filed November 6 19 66  
Application for plugging approved November 6 19 66  
Plugging commenced November 7 19 66  
Plugging completed November 7 19 66  
Reason for abandonment of well or producing formation Dry

If a producing well is abandoned, date of last production \_\_\_\_\_ 19\_\_\_\_  
Was permission obtained from the Conservation Division or its agents before plugging was commenced? Yes

Name of Conservation Agent who supervised plugging of this well Archie Elving, Pratt, Kansas  
Producing formation None Depth to top \_\_\_\_\_ Bottom \_\_\_\_\_ Total Depth of Well 4290 Feet  
Show depth and thickness of all water, oil and gas formations.

OIL, GAS OR WATER RECORDS

CASING RECORD

FORMATION	CONTENT	FROM	TO	SIZE	PUT IN	PULLED OUT

Describe in detail the manner in which the well was plugged, indicating where the mud fluid was placed and the method or methods used in introducing it into the hole. If cement or other plugs were used, state the character of same and depth placed, from \_\_\_\_\_ feet to \_\_\_\_\_ feet for each plug set.

Plugged with 25 sax common cement @ 210'  
30 sax common cement @ 60'  
5 sax at rathole & mousehole  
Plug down at 4:00 p.m., November 7, 1966

RECEIVED  
STATE CORPORATION COMMISSION

NOV 8 1966

11-8-66

CONSERVATION DIVISION  
WICHITA, KANSAS

(If additional description is necessary, use BACK of this sheet)

Name of Plugging Contractor MACK OIL CO.  
Address P. O. Box 400, Duncan, Oklahoma 73533

STATE OF KANSAS COUNTY OF SEDGWICK, ss.  
Robert L. Harris (employee of owner) or (owner or operator) of the above-described well, being first duly sworn on oath, says: That I have knowledge of the facts, statements, and matters herein contained and the log of the above-described well as filed and that the same are true and correct. So help me God.

(Signature) Robert L. Harris

812 Union Center Bldg., Wichita, Kansas 67202  
(Address)

SUBSCRIBED AND SWORN TO before me this 7th day of November, 19 66

Elizabeth F. Nice  
Elizabeth F. Nice Notary Public.

My commission expires September 21, 1968

MACK OIL COMPANY  
Duncan, Oklahoma

DRILLERS WELL LOG

#1 Margaret

Commenced R. D.: 10-26-66  
Completed R. D.: 11- 6-66  
Rotary Total Depth: 4290'

C NW SE - Section 27-27S-7W  
Kingman County, Kansas  
Elevation: 1603' Kelly Bushing  
Initial Production: Dry  
Contractor: Mack Oil Company

<u>STRATA</u>	<u>DEPTH</u>
Top Soil & Shale	0 - 252'
Shale & Shells	252 - 1000
Lime & Shale	1000 - 2005
Shale & Lime	2005 - 2626
Lime	2626 - 3180
Sand & Lime	3180 - 3313
Lime	3313 - 3952
Chert	3952 - 4043
Lime	4043 - 4084
Lime & Chert	4084 - 4140
Lime	4140 - 4290'

RECEIVED  
STATE CORPORATION COMMISSION

NOV 8 1966

11-8-66

CONSERVATION DIVISION  
DUNCAN, KANSAS

I hereby certify that the above is a true and correct log of said well as reflected by the daily drilling reports.

MACK OIL COMPANY

By

*Robert L. Harris*  
Robert L. Harris

Signed and sworn to in my presence this 8th day of November, 1966,  
by Robert L. Harris, representative of Mack Oil Company.

*Elizabeth F. Nice*  
Elizabeth F. Nice, Notary Public

My Commission Expires September 21, 1968