


STATE OF KANSAS
 STATE CORPORATION COMMISSION
 CONSERVATION DIVISION
 P. O. BOX 17027
 WICHITA, KANSAS 67217

FORM CP-4

WELL PLUGGING RECORD

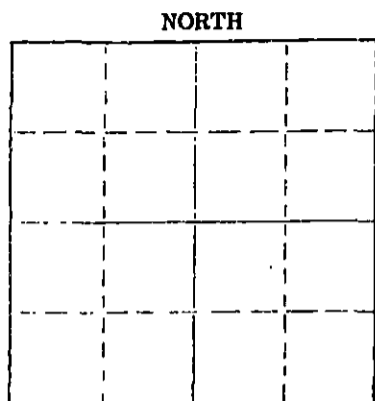

Locate well correctly on above Section Plat

Kingman County. Sec. 21 Twp. 27S Rge. 7W (EX) (W)
 Location as "NE/CNW/SW" or footage from lines. C SW SE
 Lease Owner Barnett Oil, Inc.
 Lease Name O'Neal #1 Well No. 1
 Office Address 125 North Market, Wichita, Kansas 67202
 Character of Well (completed as Oil, Gas or Dry Hole) Dry Hole
 Date well completed August 16, 1976 19
 Application for plugging filed August 16, 1976 19
 Application for plugging approved August 16, 1976 19
 Plugging commenced 5:00 PM, August 16, 1976 19
 Plugging completed 7:00 PM, August 16, 1976 19
 Reason for abandonment of well or producing formation Dry Hole

If a producing well is abandoned, date of last production 19
 Was permission obtained from the Conservation Division or its agents before plugging was commenced? Yes

Name of Conservation Agent who supervised plugging of this well G. R. Biberstein
 Producing formation _____ Depth to top _____ Bottom _____ Total Depth of Well 1268' Feet
 Show depth and thickness of all water, oil and gas formations.

OIL, GAS OR WATER RECORDS

CASING RECORD

FORMATION	CONTENT	FROM	TO	SIZE	PUT IN	PULLED OUT
				8 5/8"	231'	None

Describe in detail the manner in which the well was plugged, indicating where the mud fluid was placed and the method or methods used in introducing it into the hole. If cement or other plugs were used, state the character of same and depth placed, from _____ feet to _____ feet for each plug set.

Filled hole with heavy mud.
 Heavy mud to 230' with 25 sacks cement;
 heavy mud to 40' with solid bridge and
 1/4 sack hulls; 15 sacks to surface;
 2 sacks in rathole.

8-3076

(If additional description is necessary, use BACK of this sheet)

Name of Plugging Contractor Sterling Drilling Company
 Address P. O. Box 129, Sterling, Kansas 67579

STATE OF KANSAS COUNTY OF RICE
 F. A. Wuellner (employee of owner) or (owner or operator) of the above-described

well, being first duly sworn on oath, says: That I have knowledge of the facts, statements, and matters herein contained and the log of the above-described well as filed and that the same are true and correct. So help me God. STERLING DRILLING COMPANY

(Signature) F. A. Wuellner
 F. A. Wuellner, Secretary
 P. O. Box 129, Sterling, Kansas 67579
 (Address)

SUBSCRIBED AND SWORN TO before me this 21st day of August, 1976

Bernard Laudermilk
 Bernard Laudermilk, Notary Public.

My commission expires _____

BERNARD LAUDERMILK—NOTARY PUBLIC
 My Commission Expires Jan. 22, 1978

15-095-20507-0000

STERLING DRILLING COMPANY
P. O. Box 129
Sterling, Kansas 67579

WELL LOG ----- O'NEAL #1
Located: C SW SE, Section 21-27S-7E, Kingman County, Kansas

OWNER: Barnett Oil, Inc.
ROTARY DRILLING CONTRACTOR: Sterling Drilling Company

COMMANCED: August 7, 1976
COMPLETED: August 16, 1976

TOTAL DEPTH: 4268'

<u>LOG</u>		<u>CASING RECORD</u>
0 - 233	Sand and Shale	Ran 6 joints 8 5/8" used casing, 222' set at 234' K.B. with 200 sacks cement, 2 1/2 gal, 3 1/2 cc. Plug down at 6:45 AM, 8-8-76.
233 - 4095	Lime and Shale	
4095 - 4190	Lime	
4190 - 4268	Lime and Shale	Plugged.

8-30-76