

CARD MUST BE TYPED

EL 5851

State of Kansas
NOTICE OF INTENTION TO DRILL

(see rules on reverse side)

CARD MUST BE SIGNED

Starting Date: 6 17 1985
month day year

API Number 15- 095-21,528-0000

OPERATOR: License # 8334
Name HI-ENERGY PETROLEUM, INC.
Address 3125 E Boston
City/State/Zip Wichita, Kansas 67211
Contact Person Daniel G. Stevens
Phone (316) 683-0427

NW NW SW Sec 15 Twp 27 S, Rge 7
(location) East West

2310 Ft North from Southeast Corner of Section
5115 Ft West from Southeast Corner of Section
(Note: Locate well on Section Plat on reverse side)

CONTRACTOR: License # 5840
Name BRANDT DRILLING CO., INC.
City/State Wichita, Kansas 67202

Nearest lease or unit boundary line 165 feet.
County KINGMAN

Lease Name HERMAN Well# HEPH #1

Well Drilled For: Well Class: Type Equipment:
 Oil Swd Infield Mud Rotary
 Gas Inj Pool Ext. Air Rotary
 OWWO Expl Wildcat Cable

Domestic well within 330 feet: yes no
Municipal well within one mile: yes no

If OWWO: old well info as follows:
Operator
Well Name
Comp Date Old Total Depth
Projected Total Depth 4300 feet
Projected Formation at TD Mississippi
Expected Producing Formations

Depth to Bottom of fresh water 80 feet
Lowest usable water formation Harper Sandstone in HC
Depth to Bottom of usable water 200 feet
Surface pipe by Alternate: 1 2
Surface pipe to be set 200+ feet
Conductor pipe if any required None feet
Ground surface elevation feet MSL
This Authorization Expires 12-12-85
Approved By 6-12-85 *R*

I certify that we will comply with K.S.A. 55-101, et seq., plus eventually plugging hole to K.C.C. specifications.

Date 5-21-85 Signature of Operator or Agent

Frank Br... Title _____ Agent _____
MHC/UDHE 6-12-85 Form C-1 4/84


RECEIVED
STATE CORPORATION COMMISSION

Must be filed with the K.C.C. five (5) days prior to commencing well
This card void if drilling not started within six (6) months of date received by K.C.C.

MAY 22 1985

5-22-85

CONSERVATION DIVISION
A Regular Section of Land
Wichita, Kansas
1 Mile = 5,280 Ft.

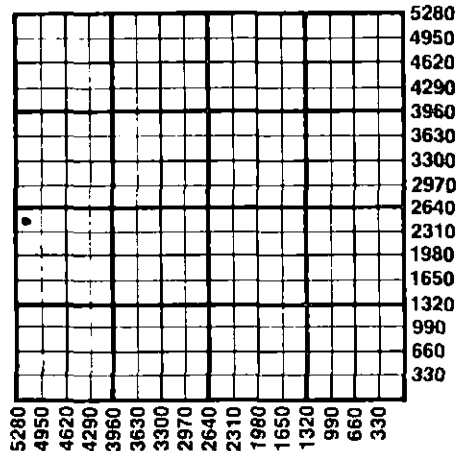

Important procedures to follow :

1. Notify District office before setting surface casing.
2. Set surface casing by circulating cement to the top.
3. File completion forms ACO-1 with K.C.C. within 90 days of well completion, following instructions on ACO-1, side 1, and including copies of wireline logs.
4. Notify District office 48 hours prior to old well workover or re-entry.
5. Prior to plugging, prepare a plugging plan, then obtain agreement from the appropriate district office for an approved plugging plan.
6. Submit plugging report (CP-4) to K.C.C. after plugging is completed.
7. Obtain an approved injection docket number before disposing of salt water.
8. Notify K.C.C. within 10 days when injection commences or terminates.
9. If an alternate 2 completion, cement in the production pipe from below any usable water to surface within 120 days of spud date.

State Corporation Commission of Kansas
Conservation Division
200 Colorado Derby Building
Wichita, Kansas 67202
(316) 263-3238