

CARD MUST BE TYPED

State of Kansas
NOTICE OF INTENTION TO DRILL
(see rules on reverse side)

CARD MUST BE SIGNED

Starting Date: June 15, 1985
month day year

API Number 15- 191-21, 202-A0001

OPERATOR: License # 7186

SE NE NE Sec. 14 Twp 32 S, Rge 2
(location) East West

Name .. Docking Development Company
Address P.O. Box 928
City/State/Zip .. Arkansas City, Kansas 67005
Contact Person .. O. L. Bartelson
Phone .. 316/455-3444

4,580 Ft North from Southeast Corner of Section
220 Ft West from Southeast Corner of Section
(Note: Locate well on Section Plat on reverse side)

CONTRACTOR: License # 6055
Name .. M. & B. Well Service, Inc.
City/State .. Wellington, Kansas

Nearest lease or unit boundary line 360 feet.
County Sumner
Lease Name .. Meredith Well# .. #1

Well Drilled For: Well Class: Type Equipment:
 Oil Swd Infield Mud Rotary
 Gas Inj Pool Ext. Air Rotary
 OWWO Expl Wildcat Cable

Domestic well within 330 feet: yes no
Municipal well within one mile: yes no

If OWWO: old well info as follows:
Operator .. Docking Development Co.
Well Name .. Meredith #1
Comp Date .. 3-1-81 .. Old Total Depth .. 2021
Projected Total Depth 2100 feet
Projected Formation at TD .. Stalnaker
Expected Producing Formations .. Stalnaker

Depth to Bottom of fresh water 250 feet
Lowest usable water formation .. Wellington
Depth to Bottom of usable water 190 ~~190~~ 250 feet
Surface pipe by Alternate: 1 2
Surface pipe to be set ~~750~~ 273 feet
Conductor pipe if any required feet
Ground surface elevation 1165 feet MSL
This Authorization Expires 11-24-85
Approved By 5-24-85 [Signature]

I certify that we will comply with K.S.A. 55-101, et seq., plus eventually plugging hole to K.C.C. specifications.


Date May 23, 1985
Signature of Operator or Agent [Signature]

[Signature] Title Office Manager

Must be filed with the K.C.C. five (5) days prior to commencing well
 This card void if drilling not started within six (6) months of date received by K.C.C.

RECEIVED
 STATE CORPORATION COMMISSION
 Important procedures to follow:

A Regular Section of Land
 1 Mile = 5,280 Ft.

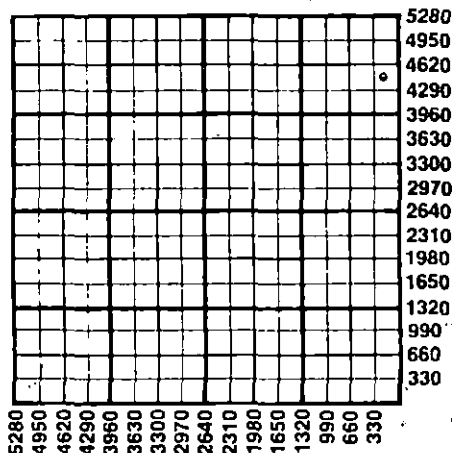

1. Notify District office before setting surface casing.
2. Set surface casing by circulating cement to the top.
3. File completion forms ACO-1 with K.C.C. within 90 days of well completion, following instructions on ACO-1, side I, and including copies of wireline logs.
4. Notify District office 48 hours prior to old well workover or re-entry.
5. Prior to plugging, prepare a plugging plan, then obtain agreement from the appropriate district office for an approved plugging plan.
6. Submit plugging report (CP-4) to K.C.C. after plugging is completed.
7. Obtain an approved injection docket number before disposing of salt water.
8. Notify K.C.C. within 10 days when injection commences or terminates.
9. If an alternate 2 completion, cement in the production pipe from below any usable water to surface within 120 days of spud date.

State Corporation Commission of Kansas
 Conservation Division
 200 Colorado Derby Building
 Wichita, Kansas 67202
 (316) 263-3238