

CARD MUST BE TYPED

NOTICE OF INTENTION TO DRILL

CARD MUST BE SIGNED

(see rules on reverse side)

Starting Date: March 29, 1985 month day year

API Number 15- 095-21,523-0000

OPERATOR: License # 5188 Name Silver Creek Oil & Gas, Inc. Address 1900 No. Amidon, Ste. 221 City/State/Zip Wichita, KS 67203 Contact Person Gregory B. Porterfield Phone (316) 832-0603

SE SE SW Sec 3 Twp 27 S, Rge 7 West (location) 330 Ft North from Southeast Corner of Section 3135 Ft West from Southeast Corner of Section (Note: Locate well on Section Plat on reverse side)

CONTRACTOR: License # 5107 Name H-30 Drilling Co. City/State Wichita, KS

Nearest lease or unit boundary line 330 feet. County Kingman Lease Name McCutchen Well# 1

Well Drilled For: Well Class: Type Equipment: Oil Swd Infield Mud Rotary Gas Inj Pool Ext Air Rotary OWWO Expl Wildcat Cable

Domestic well within 330 feet: yes no Municipal well within one mile: yes no

If OWWO: old well info as follows:

Operator Well Name Comp Date Old Total Depth Projected Total Depth 4250 Projected Formation at TD Simpson Expected Producing Formations Viola

Depth to Bottom of fresh water 50 feet Lowest usable water formation Harper Sandstone Depth to Bottom of usable water 200 feet Surface pipe by Alternate: 1 checked 2 Surface pipe to be set 200 feet Conductor pipe if any required None feet Ground surface elevation feet MSL This Authorization Expires 9-29-85 Approved By 3-29-85

I certify that we will comply with K.S.A. 55-101, et seq., plus eventually plugging hole to K.C.C. specifications.

Date 3/27/85 Signature of Operator or Agent

Signature of Secretary Title Secretary MHC/NOHE 4-1-85

Must be filed with the K.C.C. five (5) days prior to commencing well  
 This card void if drilling not started within six (6) months of date received by K.C.C.


3-29-85

RECEIVED  
 STATE CORPORATION COMMISSION

Important procedures to follow

MAR 29 1985  
 CONSERVATION DIVISION  
 Wichita, Kansas

A Regular Section of Land  
 1 Mile = 5,280 Ft.

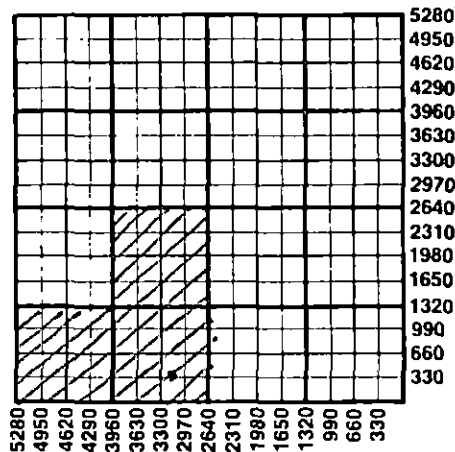

1. Notify District office before setting surface casing.
2. Set surface casing by circulating cement to the top.
3. File completion forms ACO-1 with K.C.C. within 90 days of completion, following instructions on ACO-1, side 1, and including copies of wireline logs.
4. Notify District office 48 hours prior to old well workover or re-entry.
5. Prior to plugging, prepare a plugging plan, then obtain agreement from the appropriate district office for an approved plugging plan.
6. Submit plugging report (CP-4) to K.C.C. after plugging is completed.
7. Obtain an approved injection docket number before disposing of salt water.
8. Notify K.C.C. within 10 days when injection commences or terminates.
9. If an alternate 2 completion, cement in the production pipe from below any usable water to surface within 120 days of spud date.

State Corporation Commission of Kansas  
 Conservation Division  
 200 Colorado Derby Building  
 Wichita, Kansas 67202  
 (316) 263-3238