

STATE CORPORATION COMMISSION OF KANSAS
OIL & GAS CONSERVATION DIVISION

WELL COMPLETION OR RECOMPLETION FORM
ACO-1 WELL HISTORY

DESCRIPTION OF WELL AND LEASE

Operator: License # 5181
Name DONALD C. SLAWSON
Address 200 Douglas Building
City/State/Zip Wichita, Kansas 67202

Purchaser: Inland Purchasing & Transportation

Operator Contact Person Bill Horigan
Phone (316) 263-3201

Contractor: License # 5657
Name SLAWSON DRILLING CO., INC.

Wellsite Geologist: Jeff Stewart
Phone (316) 263-3201

Designate Type of Completion

- New Well Re-Entry Workover
- Oil SWD Temp Abd
- Gas Inj Delayed Comp.
- Dry Other (Core, Water Supply etc.)

If OWWO: old well info as follows:

Operator
Well Name
Comp. Date Old Total Depth

WELL HISTORY

Drilling Method:

- Mud Rotary Air Rotary Cable

10/17/85 10/25/85 11/9/85
Spud Date Date Reached TD Completion Date
3706' 3706'
Total Depth PBDT

Amount of Surface Pipe Set and Cemented at 221 feet
Multiple Stage Cementing Collar Used? Yes No
If yes, show depth set feet
If alternate 2 completion, cement circulated from feet depth to w/SX cmt

API NO. 15-173-20,746-0000
County Sedgwick
100'E
NW SE NE Sec 11 Twp 29S Rge 1 East West

3630 Ft North from Southeast Corner of Section
890 Ft West from Southeast Corner of Section
(Note: Locate well in section plat below)


Lease Name Killion Hill Unit A Well # 3

Field Name Unnamed Jenster

Producing Formation Simpson

Elevation: Ground 1286 KB 1292

Section Plat

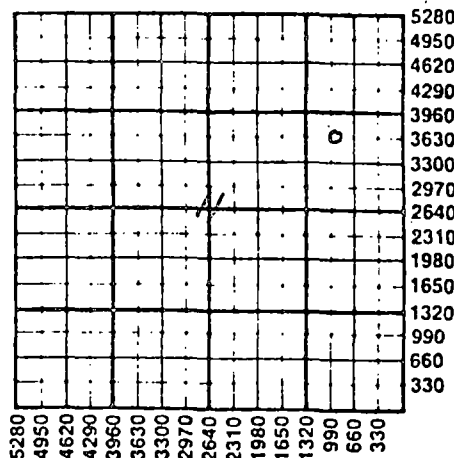

WATER SUPPLY INFORMATION

Disposition of Produced Water: Disposal Repressuring
Docket #

Questions on this portion of the ACO-1 call:

Water Resources Board (913) 296-3717

Source of Water:
Division of Water Resources Permit #

- Groundwater Ft North from Southeast Corner (Well) Ft West from Southeast Corner Sec Twp Rge East West
- Surface Water Ft North from Southeast Corner (Stream, pond etc) Ft West from Southeast Corner Sec Twp Rge East West
- Other (explain) (purchased from city, R.W.D. #)

INSTRUCTIONS: This form shall be completed in duplicate and filed with the Kansas Corporation Commission, 200 Colorado Derby Building, Wichita, Kansas 67202, within 90 days after completion or recompletion of any well. Rule 82-3-130 and 82-3-107 apply. Information on side two of this form will be held confidential for a period of 12 months if requested in writing and submitted with the form. See rule 82-3-107 for confidentiality in excess of 12 months. One copy of all wireline logs and drillers time log shall be attached with this form. Submit CP-4 form with all plugged wells. Submit CP-111 form with all temporarily abandoned wells.

All requirements of the statutes, rules and regulations promulgated to regulate the oil and gas industry have been fully complied with and the statements herein are complete and correct to the best of my knowledge.

Signature William R. Horigan
Title Kansas Operations Manager Date 12/30/85

Subscribed and sworn to before me this 30 day of December 1985
Notary Public Leslie K. Robinson
Date Commission Expires 5-27-89



K.C.C. OFFICE USE ONLY
 Letter of Confidentiality Attached
 Wireline Log Received
 Drillers Time Log Received
Distribution
 KCC SWD/Rep NGPA
 KGS Plug Other (Specify)
RECEIVED

Form ACO-1 (7-84) CORPORATION COMMISSION

JAN 30 1986

Sec. 11 Twp. 29S Rge. 1E