

STATE OF KANSAS STATE CORPORATION COMMISSION

SEP 2 1982 9-2-82 CONSERVATION DIVISION Wichita, Kansas


WELL PLUGGING RECORD

Give All Information Completely Make Required Affidavit Mail or Deliver Report to Conservation Division State Corporation Comm. 245 North Water Wichita, KS 67202

Stafford County, Sec. 7 Twp. 24S Rge. 15 E/W Location as "NE/CNW 1/4 SW 1/4" or footage from lines NW 1/4 NE 1/4 SE 1/4

Lease Owner Hummon Corporation Lease Name Walker Well No. 1 Office Address 400 One Main Place, Wichita, KS Character of Well (Completed as Oil, Gas or Dry Hole) Dry Hole

Date Well completed 8-25-82 19 Application for plugging filed 8-25-82 19 Application for plugging approved 8-25-82 19 Plugging commenced 8-25-82 19 Plugging completed 8-25-82 19 Reason for abandonment of well or producing formation

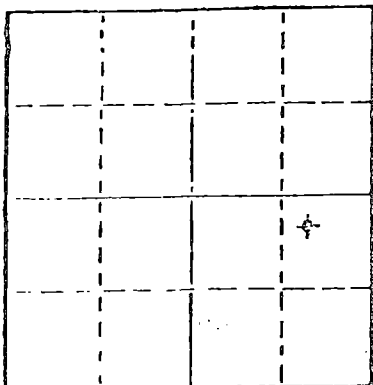

Locate well correctly on above Section Plot

If a producing well is abandoned, date of last production 19

Was permission obtained from the Conservation Division or its agents before plugging was commenced? Yes

Name of Conservation Agent who supervised plugging of this well J.H. Metz, Stafford, KS

Producing formation Depth to top Bottom Total Depth of Well

Show depth and thickness of all water, oil and gas formations. 4165'

OIL, GAS OR WATER RECORDS

CASING RECORD

Table with 7 columns: FORMATION, CONTENT, FROM, TO, SIZE, PUT IN, PULLED OUT. Row 1: Surface, 0, 426', 8-5/8", yes, no.

Describe in detail the manner in which the well was plugged, indicating where the mud fluid was placed and the method or methods used in introducing it into the hold. If cement or other plugs were used, state the character of same and depth placed, from feet to feet for each plug set.

1st plug @ 770' w/ 60 sx. 50-50 Poz 2% gel 3% cc 2nd plug @ 400' w/ 40 sx. 3rd & bridge @ 40' w/ 10 sx. 10 sx. in rathole, 10 sx. in mousehole. Job complete @ 4:00 p.m. 8-25-82

(If additional description is necessary, use BACK of this sheet)

Name of Plugging Contractor Big-H Drilling, Inc.

STATE OF KANSAS COUNTY OF SEDGWICK, ss. Wilber Berg of Hummon Corporation (employee of owner) or (owner or operator) of the above-described well, being first duly sworn on oath, says: That I have knowledge of the facts, statements, and matters herein contained and the log of the above-described well as filed and that the same are true and correct. So help me God.

(Signature) Wilber D Berg 400 One Main Place, Wichita, Kansas (Address)

SUBSCRIBED AND SWORN TO before me this 27th day of August, 19 82 SANDRA L. MENDOZA STATE NOTARY PUBLIC SEDGWICK COUNTY, KANSAS MY APPT. EXP. 2/13/86 Sandra L. Mendoza Notary Public.

My Commission expires 2/13/86

DRILLERS LOG

#1 Walker

CASING RECORD:	COMPANY:	Hummon Corporation	DESCRIPTION:
8-5/8" @ 426' w/ 300 sx. cement	CONTRACTOR:	Big-H Drilling, Inc.	NW NE SE Sec. 7-24S-15W Stafford County, Kansas
PLUGGED & ABANDONED	COMMENCED:	August 14, 1982	TOTAL DEPTH: 4165'
	COMPLETED:	August 25, 1982	

<u>FORMATION</u>	<u>FROM</u>	<u>TO</u>	<u>REMARKS</u>
Shale & Sand	0	430	
Shale & Red Beds	430	1538	
Shale & Lime	1538	1910	
Lime & Shale	1910	2183	
Shale & Lime	2183	2672	
Lime & Shale	2672	2680	
Shale & Lime	2680	2713	
Lime & Shale	2713	3100	
Shale & Lime	3100	3517	
Lime & Shale	3517	3693	
Shale & Lime	3693	3777	
Lime & Shale	3777	3949	
Shale & Lime	3949	4031	
Lime & Shale	4031	4091	
Sand, Lime & Shale	4091	4096	
Shale & Lime	4096	4099	
Lime	4099	4143	
Lime & Shale	4143	4165	
RTD	4165		

I certify that this is a true and correct copy of the above log to the best of my knowledge.

BIG-H DRILLING, INC.

Karen R. Tappin

Subscribed and sworn to before me this 27th day of August, 1982.

SANDRA L. MENDOZA STATE NOTARY PUBLIC SEDGWICK COUNTY, KANSAS MY APPT. EXP. 2/13/86
--

Sandra L. Mendoza
Notary Public

RECEIVED
STATE CORPORATION COMMISSION

SEP 2 1982

CONSERVATION DIVISION
Wichita, Kansas