

STATE OF KANSAS
STATE CORPORATION COMMISSION

Form CP-4

Give All Information Completely
Make Required Affidavit
Mail or Deliver Report to:
Conservation Division
State Corporation Commission
212 No. Market
Wichita, Kansas 67202

WELL PLUGGING RECORD

Stafford County, Sec. 10 Twp. 24 Rge. 15 (E) W (W)

Location as "NE/CNW/SW" or footage from lines NW NW NE

Lease Owner Hellar Drilling Co., Inc.

Lease Name Nagel Well No. # 3

Office Address 339 Union Center ; Wichita, Kans. 67202

Character of Well (completed as Oil, Gas or Dry Hole) _____

Date well completed _____ 19__

Application for plugging filed July 1971

Application for plugging approved August 1971


Plugging commenced August 6 1971

Plugging completed August 20 1971

Reason for abandonment of well or producing formation _____

If a producing well is abandoned, date of last production _____ 19__

Was permission obtained from the Conservation Division or its agents before plugging was commenced? Yes

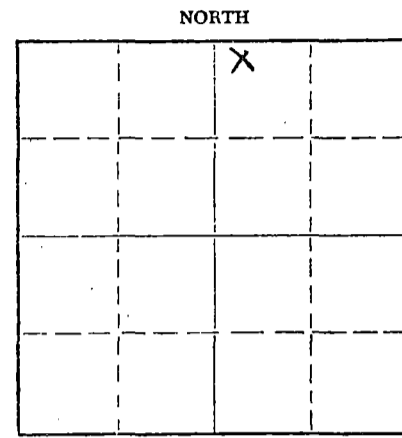

Locate well correctly on above Section Plat

Name of Conservation Agent who supervised plugging of this well Russell Biberstein

Producing formation _____ Depth to top _____ Bottom _____ Total Depth of Well _____ Feet

Show depth and thickness of all water, oil and gas formations.

OIL, GAS OR WATER RECORDS

CASING RECORD

FORMATION	CONTENT	FROM	TO	SIZE	PUT IN	PULLED OUT
				8 5/8	232	None
				4 1/2	4110	2615

Describe in detail the manner in which the well was plugged, indicating where the mud fluid was placed and the method or methods used in introducing it into the hole. If cement or other plugs were used, state the character of same and depth placed, from _____ feet to _____ feet for each plug set.

August 6, 1971 Plugged off bottom. Dumped sand to 3900'. Mixed and dumped 4 sx of cement.

August 20, 1971 Plugged off top. Allied Cementing Co. mixed and pumped down 8 5/8" surface casing: 2 sx hulls, 15 sx gel and 100 sx of cement.

RECEIVED
STATE CORPORATION COMMISSION
SEP 21 1971
CONSERVATION DIVISION
Wichita, Kansas
9-21-71

(If additional description is necessary, use BACK of this sheet)

Name of Plugging Contractor RUSS CASING PULLING, INC.

Address P. O. Box 1082 ; Great Bend, Kansas 67530

STATE OF Kansas, COUNTY OF Sedgwick, ss.

D. L. Hellar, Pres. of Hellar Drlg. Co. Inc. (employee of owner) or (owner or operator) of the above-described well, being first duly sworn on oath, says: That I have knowledge of the facts, statements, and matters herein contained and the log of the above-described well as filed and that the same are true and correct. So help me God.


(Signature) [Signature]

D. L. Hellar - President
339 Union Center Bldg.
Wichita, Kansas (Address) 67202

SUBSCRIBED AND SWORN TO before me this 20th day of September, 1971

[Signature]
Catherine Darcey - Notary Public.

My commission expires March 25, 1972

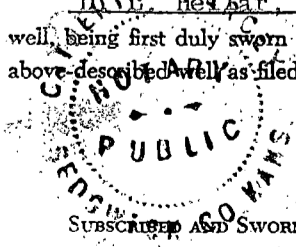

WILKINSON DRILLING, INC.
805 UNION CENTER
WICHITA 2, KANSAS

RECEIVED
STATE CORPORATION COMMISSION
JUL 29 1971
CONSERVATION DIVISION
Wichita, Kansas

May 12, 1961

DRILLERS LOG

Wilkinson Drilling, Inc.
NAGEL No. 3

NW NW NE, Sec. 10-24S-15W
Stafford County, Kansas

Contractor: Company Tools
Commenced: April 7, 1961
Completed: April 17, 1961
Total Depth: 4130'
Elevation: 2032 Kelly Bushing
Surface Casing: 8 5/8" @ 232' w/185 sx. cmt.

FIGURES INDICATE BOTTOMS OF FORMATION:

<u>Depth</u>	<u>Formation</u>
0 - 145	Surface soil and sand
145 - 235	Shale and shells
235 - 370	Shale
370 - 450	Red bed
450 - 500	Sand
500 - 735	Red bed
735 - 965	Shale and shells
965 - 998	Anhydrite
998 - 1266	Shale
1266 - 1665	Shale and shells
1665 - 3537	Lime and shale
3537 - 3636	Shale
3636 - 3912	Lime
3912 - 3974	Shale and lime
3974 - 4028	Chert
4028 - 4090	Shale and sand
4090 - 4130	Arbuckle dolomite

4 1/2" @ 4110
w/50 saf
Temp survey
TOC 3695
138 jnts tubing


We hereby certify the above and foregoing to be a true and correct copy of the log of the Nagel No. 3, located in the NW/4 NW/4 NE/4 of Section 10-24S-15W, Stafford County, Kansas.

WILKINSON DRILLING, INC.

Walter M. Wilkinson
Walter M. Wilkinson-Pres.

Subscribed and sworn to before me this twelfth day of May, 1961.

Carolyn K. Iverson
Carolyn K. Iverson-Notary Public

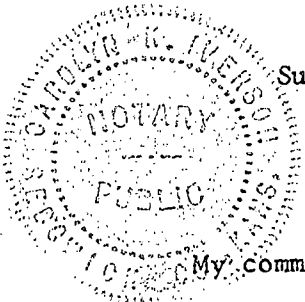

My commission expires January 2, 1965.

Russ Sullivan.