

STATE OF KANSAS
STATE CORPORATION COMMISSION

Form CP-4

Give All Information Completely
Make Required Affidavit
Mail or Deliver Report to:
Conservation Division
State Corporation Commission
211 No. Broadway
Wichita, Kansas

WELL PLUGGING RECORD

Stafford County, Sec. 10 Twp. 24 Rge. 15 (E) (W)

Location as "NE/CNW%SW%" or footage from lines SE SE NE

Lease Owner Wilkinson Drilling, Inc.

Lease Name Nagel Well No. 1

Office Address 805 Union Center Wichita, Kansas

Character of Well (completed as Oil, Gas or Dry Hole)

Date well completed 19

Application for plugging filed 7-22-64 19

Application for plugging approved 7-23-64 19

Plugging commenced 7-23-64 19


Plugging completed 9-24-64 19

Reason for abandonment of well or producing formation

Dry

If a producing well is abandoned, date of last production 19

Was permission obtained from the Conservation Division or its agents before plugging was commenced? Yes

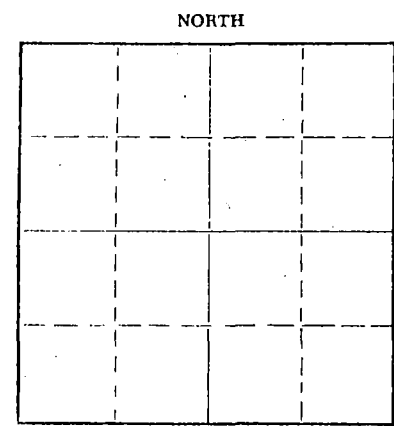

Locate well correctly on above Section Plat

Name of Conservation Agent who supervised plugging of this well Archie V. Elving

Producing formation Depth to top Bottom Total Depth of Well PB3799 Feet

Show depth and thickness of all water, oil and gas formations.

OIL, GAS OR WATER RECORDS

CASING RECORD

FORMATION	CONTENT	FROM	TO	SIZE	PUT IN	PULLED OUT
				8 5/8	232'	None
				1 1/2	None	2500'

Describe in detail the manner in which the well was plugged, indicating where the mud fluid was placed and the method or methods used in introducing it into the hole. If cement or other plugs were used, state the character of same and depth placed, from feet to feet for each plug set.

Rigged up unit. Started to clean out cellar.

Finished cleaning out cellar. Sanded to 3770'. Dumped 3 sacks of cement. Working pipe.

Spotted 60 bbl of oil.

Shot pipe at 2800'. Working pipe. Shot pipe at 2715' - 2618' and 2500'. Pulling pipe.

Pulling pipe.

Build bridge at 40'. Spudded on bridge.

Squeezed well with 10 sacks of mud and 75 sacks of cement.

RECEIVED
STATE CORPORATION COMMISSION
SEP 30 1964
09-30-64
CONSERVATION DIVISION
Wichita, Kansas

(If additional description is necessary, use BACK of this sheet)

Name of Plugging Contractor Forbes Casing Pulling, Inc.

Address P. O. Box 221 Great Bend, Kansas

STATE OF Kansas, COUNTY OF Barton, ss.

J. O. Forbes (employee of owner) or (owner or operator) of the above-described

well, being first duly sworn on oath, says: That I have knowledge of the facts, statements, and matters herein contained and the log of the above-described well as filed and that the same are true and correct. So help me God.

(Signature) J. O. Forbes

P. O. Box 221 Great Bend, Kansas

(Address)

SUBSCRIBED AND SWORN TO before me this 28 day of September, 1964

Notary Public

My commission expires May 27, 1965

WILKINSON DRILLING, INC.
805 UNION CENTER
WICHITA 2, KANSAS

NAGEL #1

Company: Wilkinson Drilling, Inc.
Contractor: Company Tools
Commenced: April 6, 1958
Completed: April 7, 1958
Total Depth: 4100 feet
Location: SE/4 SE/4 NE/4 Section 10-24S-15W
Stafford County, Kansas
Elevation: 2027 KB
Casing: 4½" @ 3895' w/150 sacks cement

This was a wash-down of the Vickers No. 1 Nagel, drilled in July, 1953. Therefore, no drillers log available from us.

WILKINSON DRILLING, INC.

Walter M. Wilkinson, President

RECEIVED
STATE CORPORATION COMMISSION

NOV 10 1964

CONSERVATION DIVISION
Wichita, Kansas