

WELL PLUGGING RECORD

Give All Information Completely
Make Required Affidavit
Mail or Deliver Report to:
Conservation Division
State Corporation Commission
211 No. Broadway
Wichita, Kansas

Stafford

County. Sec. 9 Twp. 24S Rge. (E) 15 (W)

Location as "NE/CNW/SW" or footage from lines App. E/2 NW/4 NW/4

Lease Owner Hellar Drilling Company, Inc.

Lease Name Birdsall Well No. 1

Office Address 1014 Union Center, Wichita, Kansas

Character of Well (completed as Oil, Gas or Dry Hole) Dry Hole

Date well completed March 13 1964

Application for plugging filed March 13 1964

Application for plugging approved March 13 1964


Plugging commenced March 13 1964

Plugging completed March 13 1964

Reason for abandonment of well or producing formation Dry Hole

If a producing well is abandoned, date of last production 19

Was permission obtained from the Conservation Division or its agents before plugging was commenced? Yes

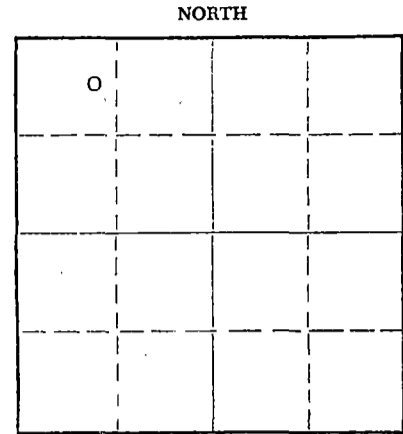

Locate well correctly on above Section Plat

Name of Conservation Agent who supervised plugging of this well Archie V. Elving, Pratt, Kansas

Producing formation _____ Depth to top _____ Bottom _____ Total Depth of Well _____ Feet

Show depth and thickness of all water, oil and gas formations.

OIL, GAS OR WATER RECORDS

CASING RECORD

FORMATION	CONTENT	FROM	TO	SIZE	PUT IN	PULLED OUT
		0	231'	8 5/8"	231'	None

Describe in detail the manner in which the well was plugged, indicating where the mud fluid was placed and the method or methods used in introducing it into the hole. If cement or other plugs were used, state the character of same and depth placed, from _____ feet to _____ feet for each plug set.

**Set Plug @ 225'/25 sacks cement & 1/4 sack hulls
Plug @ 35'/10 sacks cement**

RECEIVED
STATE CORPORATION COMMISSION

MAR 25 1964

3-25-64

CONSERVATION DIVISION
Wichita, Kansas

(If additional description is necessary, use BACK of this sheet)
Name of Plugging Contractor Hellar Drilling Company, Inc.
Address 1014 Union Center, Wichita, Kansas

STATE OF KANSAS, COUNTY OF SEDGWICK, ss.

D. L. Hellar, Pres. of Hellar Drlg. Co. (employee of owner) or (owner or operator) of the above-described well, being first duly sworn on oath, says: That I have knowledge of the facts, statements, and matters herein contained and the log of the above-described well as filed and that the same are true and correct. So help me God.

(Signature) D. L. Hellar D.L. Hellar, Pres.
1014 Union Center, Wichita, Kansas
(Address)

SUBSCRIBED AND SWORN TO before me this 20th day of March, 1964

My commission expires March 25, 1964

Catherine Darcey
Catherine Darcey - Notary Public.

DRILLER'S LOG

COMPANY: Hellar Drilling Company, Inc.
 CONTRACTOR: Hellar Drilling Company, Inc.
 LEASE: #1 Birdsall
 LOCATION: Approx. E/2 NW NW 9-24S-15W
 Stafford County, Ks.
 COMMENCED: March 2, 1964
 COMPLETED: March 13, 1964
 CASING: Set 8 5/8" surface casing @ 231'/200
 sacks cement

0- 180	Sand & shale
180- 231	Shale
231- 665	Red bed & sand
665- 972	Red Bed
972- 994	Blaine
994-1450	Sand & shale
1450-1890	Salt section, shale & shells
1890-1995	Salt section
1995-2195	Lime & shale
2195-2373	Fort Riley
2373-2905	Lime & shale
2905-3110	Shale & Lime
3110-3277	Topeka @ 3129'
3277-3710	Lime & shale
3710-3775	Lsg. K.C.
3775-3843	K. C. Lime
3843-3893	Lime
3893-3955	Lime w/shale, BKC-Marm. Sec.
3955-4026	Lime & shale
4026-4095	Marmaton shale
4095-4180	Simpson
4180	Rotary Total Depth
	D & A

RECEIVED
 STATE CORPORATION COMMISSION

MAR 25 1964

CONSERVATION DIVISION
 Wichita, Kansas

STATE OF KANSAS)
)
 COUNTY OF SEDGWICK) ss

I, D. L. Hellar, do hereby certify that the above and foregoing is a true and correct copy of the log of the #1 Birdsall, located in approx. E/2 NW/4 NW/4 9-24S-15W, Stafford County, Kansas, as reflected by the files of the Hellar Drilling Company, Inc.

HELLAR DRILLING COMPANY, INC.

By *D. L. Hellar*
 President - D. L. Hellar

Subscribed and sworn to before me, a Notary Public, in and for Sedgwick County, Kansas, this 20th day of March, 1964.

My commission expires:
 March 25, 1964

Catherine Darcey
 Notary Public-Catherine Darcey