


STATE OF KANSAS
STATE CORPORATION COMMISSION

Give All Information Completely
Make Required Affidavit
Mail or Deliver Report to:
Conservation Division
State Corporation Commission
800 Bittling Building
Wichita, Kansas

WELL PLUGGING RECORD

NORTH

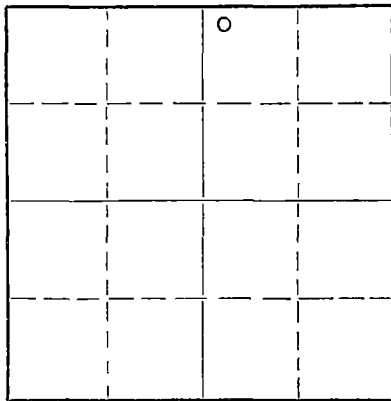

Locate well correctly on above
Section Plat

Stafford County. Sec. 9 Twp. 24S Rge. (E) 15 (W)
Location as "NE/CNW/SW" or footage from lines NW NW NE
Lease Owner National Cooperative Refinery Assoc. & Petroleum, Inc.
Lease Name Petro Well No. 1
Office Address 305 East Third, Wichita 2, Kansas
Character of Well (completed as Oil, Gas or Dry Hole) Dry Hole
Date well completed June 8, 1953
Application for plugging filed June 8, 1953
Application for plugging approved June 8, 1953
Plugging commenced June 8, 1953
Plugging completed June 8, 1953
Reason for abandonment of well or producing formation Dry Hole

If a producing well is abandoned, date of last production 19
Was permission obtained from the Conservation Division or its agents before plugging was commenced? Yes

Name of Conservation Agent who supervised plugging of this well Mr. C. D. Stough
Producing formation Depth to top Bottom Total Depth of Well 4140 Feet
Show depth and thickness of all water, oil and gas formations.

OIL, GAS OR WATER RECORDS

CASING RECORD

FORMATION	CONTENT	FROM	TO	SIZE	PUT IN	PULLED OUT
				8 5/8"	218'	None

Describe in detail the manner in which the well was plugged, indicating where the mud fluid was placed and the method or methods used in introducing it into the hole. If cement or other plugs were used, state the character of same and depth placed, from feet to feet for each plug set.

Mudded up to 210' and set wooden plug at 210'.
Placed 1/3 sack hulls on top of plug at 210'.
Cemented and displaced 20 sacks cement through
drill pipe onto plug at 210'. Mudded up to 35'
and set second wooden plug. Placed 1/3 sack
hulls on top of plug at 35'. Filled hole to
bottom of well cellar with 10 sacks cement.

6-25-53

(If additional description is necessary, use BACK of this sheet)

Name of Plugging Contractor Garvey Drilling Company
Address R. R. #2, Great Bend, Kansas

STATE OF KANSAS, COUNTY OF SEDGWICK, ss.
W. W. Fisher (employee of owner) of the above-described
well, being first duly sworn on oath, says: That I have knowledge of the facts, statements, and matters herein contained and the log of the
above-described well as filed and that the same are true and correct. So help me God.

(Signature) WW Fisher
305 East Third, Wichita 2, Kansas
(Address)

SUBSCRIBED AND SWORN TO before me this 19th day of June, 1953

Charlotte Heisman
Notary Public.

My commission expires October 13, 1954.

PLUGGING
FILE SEC 9 T 24 R 15 W
PAGE 107 LINE 2

DRILLER'S LOG PETRO NO. 1

National Cooperative Refinery Assoc. and
Petroleum, Inc., Owners

Section 9, Twp. 24S, 15W

Garvey Drilling Company, Contractor

Location: NW NW NE

Drilling Commenced: May 28, 1953

County: Stafford County, Kansas

Drilling Completed: June 9, 1953

R.T.D.: 4140'

Casing Record: 8 5/8" @ 218' w/175 sax

Production: D & A

Figures below indicate bottom of formation:

87	Sand
275	Shale
961	Red Bed & Shale
986	Anhydrite
1850	Shale & Shells
2030	Shale & Lime
2415	Lime
3330	Lime & Shale
4140	Lime

Tops:

Heebner:	3516 (-1488)
Brown Lime:	3650 (-1622)
Lansing:	3658 (-1633)
Arbuckle:	4128 (-2100)

4140' R.T.D.

I hereby certify that this is a true and correct log of the above mentioned well.

PETROLEUM, INC.

By W.W. Fisher

STATE OF KANSAS)
COUNTY OF SEDGWICK) ss:

Subscribed to and sworn to before me, a Notary Public, in said County and State, this 24th day of June, 1953.

Charlotte K. Korman
Notary Public

My commission expires: October 13, 1954

PLUGGING
FILE SEC 9 T 24 R 15W
BOOK PAGE 107 LINE 2

NOTARY PUBLIC COMMISSION
JUN 24 1953
CONSTITUTIONAL DIVISION
Wichita, Kansas