


STATE OF KANSAS
STATE CORPORATION COMMISSION

Give All Information Completely
Make Required Affidavit
Mail or Deliver Report to:
Conservation Division
State Corporation Commission
800 Bittling Building
Wichita, Kansas

WELL PLUGGING RECORD

NORTH

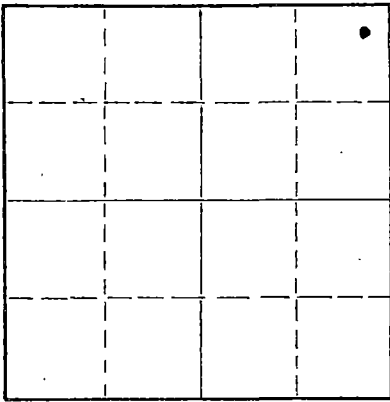

Locate well correctly on above
Section Plat

Stafford County, Sec. 5 Twp 24S Rge. (E) 15 (W)

Location as "NE/CNW/SW" or footage from lines NE - NE - NE

Lease Owner Musgrove Petroleum Corporation, Inc.

Lease Name Hoover

Well No. 1

Office Address 518 Petroleum Building, Wichita, Kansas

Character of Well (completed as Oil, Gas or Dry Hole) Dry

Date well completed October 21, 1955

Application for plugging filed 19

Application for plugging approved 19

Plugging commenced October 21, 1955

Plugging completed October 21, 1955

Reason for abandonment of well or producing formation

If a producing well is abandoned, date of last production 19

Was permission obtained from the Conservation Division or its agents before plugging was commenced? Yes

Name of Conservation Agent who supervised plugging of this well Mr. Horner - Great Bend, Kansas

Producing formation Depth to top Bottom Total Depth of Well 4228 Feet

Show depth and thickness of all water, oil and gas formations.

OIL, GAS OR WATER RECORDS

CASING RECORD

FORMATION	CONTENT	FROM	TO	SIZE	PUT IN	PULLED OUT

Describe in detail the manner in which the well was plugged, indicating where the mud fluid was placed and the method or methods used in introducing it into the hole. If cement or other plugs were used, state the character of same and depth placed, from feet to feet for each plug set.

8 5/8th O. D. Surface pipe 272.71 ft.

Cemented to surface with 225 sacks of cement.

Mud to 270 ft. 8 5/8 Halliburton Plug. 1/2 sacks Hulls

20 Sacks cement through drill pipe.

Mud to 35 ft. 8 5/8 Halliburton Plug

1/2 Sacks Hulls - Cement to bottom of cellar.

Name of Plugging Contractor Stearns Petroleum, Inc.
(If additional description is necessary, use BACK of this sheet)

Address Box 313, Russell, Kansas

STATE OF Kansas, COUNTY OF Russell, ss.

(employee of owner) or (owner or operator) of the above-described well, being first duly sworn on oath, says: That I have knowledge of the facts, statements, and matters herein contained and the log of the above-described well as filed and that the same are true and correct. So help me, God.

(Signature)


(Address)

SUBSCRIBED AND SWORN TO before me this 25 day of November, 1955

My commission expires

April 5-1958

Notary Public.

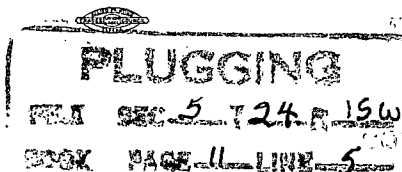

11-29-55

HOOVER #1

Operator: Mangrove Petroleum Corporation
 Contractor: Stearns Petroleum, Inc.
 Commencement Date: October 8, 1955
 Completion Date: October 21, 1955
 L.P.: D. & A.

Location:
 NE NE NE - 5-24S-15W
 Stafford County
 Kansas

Casing Record

Run 12 joints or 272.71 feet of used 4-5/8" surface pipe, set at 275', on October 9, 1955. Cemented with 225 sacks Pozmix and two sacks Calcium Chloride.

WELL LOG

Shale, Sand & Shells	0	270
Blue Shale	270	450
Sand	450	510
Red Bed	510	970
Anhydrite	970	995
Shale & Shells	995	1830
Shale & Lime	1830	2200
Shale & Shells	2200	2375
Shale & Lime	2375	2585
Shale & Shells	2585	3010
Shale & Lime	3010	3740
Lime	3740	4025
Cherty Lime	4025	4125
Lime	4125	4140
Shale & Lime	4140	4205
Arbuckle	4205	4225
Total Depth	4225	

STATE OF KANSAS)
) SS:
 COUNTY OF RUSSELL)

I hereby certify that the above information is true and correct to the best of my knowledge.


 O. C. Stearns, President

SUBSCRIBED AND SWORN to before me, a Notary Public, this 24th day of October, 1955.


 Betty Lou Miller, Notary Public

My Commission Expires:

April 5, 1958

