15-185-20460-0000


STATE OF KANSAS
STATE CORPORATION COMMISSION

Form CP-4

Give All Information Completely
Make Required Affidavit
Mail or Deliver Report to:
Conservation Division
State Corporation Commission
P. O. Box 17027
Wichita, Kansas 67217

WELL PLUGGING RECORD

NORTH

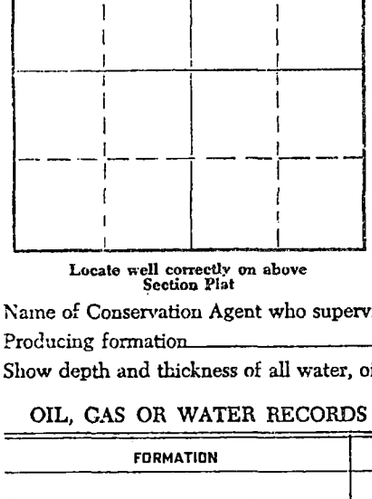

Locate well correctly on above Section Plat

Stafford County. Sec. 5 Twp. 24 Rge. 15 (E) W (W)

Location as "NE/CNW¼SW¼" or footage from lines SW NE NW

Lease Owner Aspen Drilling Co.

Lease Name Seibert Well No. 1

Office Address P. O. Box 783 ; Great Bend, Ks. 67530

Character of Well (completed as Oil, Gas or Dry Hole) _____

Date well completed _____ 19____

Application for plugging filed July 19 74

Application for plugging approved July 19 74

Plugging commenced July 12 19 74

Plugging completed July 31 19 74

Reason for abandonment of well or producing formation _____

If a producing well is abandoned, date of last production _____ 19____

Was permission obtained from the Conservation Division or its agents before plugging was commenced? Yes

Name of Conservation Agent who supervised plugging of this well Russell Biberstein

Producing formation _____ Depth to top _____ Bottom _____ Total Depth of Well _____ Feet

Show depth and thickness of all water, oil and gas formations.

OIL, GAS OR WATER RECORDS — CASING RECORD

FORMATION	CONTENT	FROM	TO	SIZE	PUT IN	PULLED OUT
				7"	283	None
				4 1/2"	2036	1503

Describe in detail the manner in which the well was plugged, indicating where the mud fluid was placed and the method or methods used in introducing it into the hole. If cement or other plugs were used, state the character of same and depth placed, from _____ feet to _____ feet for each plug set.

July 12, 1974 — Plugged off bottom. Dumped sand to 1900'. Mixed and dumped 4 sx of cement.

July 31, 1974 — Plugged off top. Sun Oil Well Cementing Co. mixed and pumped down 7" surface casing; 3 sx of hulls, 10 sx of gel and 100 sx of cement.

RECEIVED
STATE CORPORATION COMMISSION
SEP 12 1974
9-12-74
CONSERVATION DIVISION
Wichita, Kansas

(If additional description is necessary, use BACK of this sheet)

Name of Plugging Contractor RUSS CASING PULLING, INC.

Address P. O. Box 1082 ; Great Bend, Kansas 67530

STATE OF Kansas, COUNTY OF Barton, ss.

Robert L. Pelster (employee of owner) or (owner or operator) of the above-described well, being first duly sworn on oath, says: That I have knowledge of the facts, statements, and matters herein contained and the log of the above-described well as filed and that the same are true and correct. So help me God.

(Signature) R. L. Pelster

Robert L. Pelster, Great Bend, Kansas
(Address)

SUBSCRIBED AND SWORN TO before me this 10th day of September, 19 74

Theora Holleman
Notary Public.

My commission expires April 18, 1976

15-185-20460-0000

STERLING DRILLING COMPANY
P. O. Box 129
Sterling, Kansas 67579

WELL LOG - SEIBERT #1
Located: SW NE NW, Section 5-24S-15W, Stafford County, Kansas

OWNER: Aspen Drilling Company
ROTARY DRILLING CONTRACTOR: Sterling Drilling Company

COMMENCED: September 21, 1973
COMPLETED: September 25, 1973

TOTAL DEPTH: 2046'

RECEIVED
STATE CORPORATION COMMISSION
JUL 8 1974
CONSERVATION DIVISION
Wichita, Kansas

LOG		CASING RECORD
0 - 90	Clay and Gravel	Ran 9 joints 7" used casing, 284.16' set at 283' G.L. with 150 sacks 60/40 Pozmix with 3% cc. Plug down at 10:00 PM, 9-21-73.
90 - 289	Shale and Shells	
289 - 360	Shale	
360 - 1050	Shale, Anhydrite and Sand	
1050 - 1400	Shale	
1400 - 1900	Shale and Lime	
1900 - 2030	Shale, Lime and Anhydrite	
2030 - 2046	Lime	Ran 64 joints 4 1/2" 9.5# used seamless casing, 2043' set at 2036' G.L. with 420 gal. Sodium Acid Phyro Phosphate flush followed by 35 sacks 50/50 Pozmix followed by 200 gal. Latex cement. Plug down at 1:45 AM, 9-25-73.

DATE OCT 1 1973
LEASE
CHG. TO
APRVD.