


STATE OF KANSAS
STATE CORPORATION COMMISSION

Form CP-4

Give All Information Completely
Make Required Affidavit
Mail or Deliver Report to:
Conservation Division
State Corporation Commission
P. O. Box 17027
Wichita, Kansas 67217
NORTH

WELL PLUGGING RECORD

Stafford County. Sec. 4 Twp. 24S Rge. 15 (W)
Location as "NE/CNW/SW" or footage from lines C N/2 NE SE
Lease Owner Halliburton Oil Producing Company
Lease Name Lucas Well No. 1
Office Address 300 Cameron Bldg., 2915 Classen Blvd., Okla. City 73106
Character of Well (completed as Oil, Gas or Dry Hole) Gas
Date well completed July 19 71
Application for plugging filed April 26, 19 77
Application for plugging approved Verbal - April 26, 19 77
Plugging commenced April 26, 19 77
Plugging completed April 27, 19 77
Reason for abandonment of well or producing formation Excessive water and gas depleted.
If a producing well is abandoned, date of last production April 18, 1977
Was permission obtained from the Conservation Division or its agents before plugging was commenced? Yes

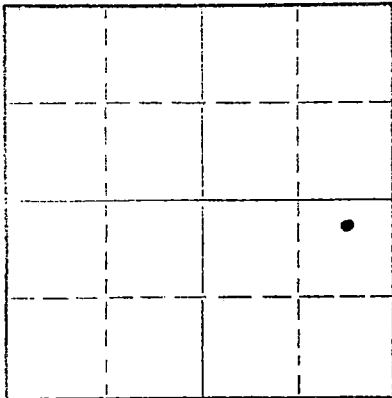

Locate well correctly on above Section Plat

Name of Conservation Agent who supervised plugging of this well Mr. Buddy Metz, Stafford, Kansas
Producing formation Neva Depth to top 2520 Bottom 2540 Total Depth of Well 3130 Feet
Show depth and thickness of all water, oil and gas formations.

OIL, GAS OR WATER RECORDS

CASING RECORD

FORMATION	CONTENT	FROM	TO	SIZE	PUT IN	PULLED OUT
Howard	Gas - Water	3070	3078	8-5/8"	250'	None
Red Eagle	Gas - Water	2584	2610	5-1/2"	3129'	1960'
Neva	Gas - Water	2520	2540			
Winfield	Gas - Water	2050	2077			

Describe in detail the manner in which the well was plugged, indicating where the mud fluid was placed and the method or methods used in introducing it into the hole. If cement or other plugs were used, state the character of same and depth placed, from _____ feet to _____ feet for each plug set.

Pumped 20 sx. cement plug 2000'-2056'. Filled hole with fluid to 350'.
Pumped 3 sx. hulls, 15 sx. gel, and 100 sx. 50/50 Pozmix cement for top plug - 0 - 350'.

RECEIVED
STATE CORPORATION COMMISSION

MAY 02 1977
5-2-77
CONSERVATION DIVISION
Wichita, Kansas

(If additional description is necessary, use BACK of this sheet)
Name of Plugging Contractor Basye Well Service as directed by company man (Karol Claypool)
Address Box 10, Stafford, Kansas 67578

STATE OF OKLAHOMA COUNTY OF OKLAHOMA, ss.
D. D. Swearingen (employee of owner) of the above-described well, being first duly sworn on oath, says: That I have knowledge of the facts, statements, and matters herein contained and the log of the above-described well as filed and that the same are true and correct. So help me God.

(Signature) D. D. Swearingen
2915 Classen Blvd., Okla. City, Okla.
(Address)

SUBSCRIBED AND SWORN to before me this 27th day of April, 19 77.

My commission expires April 24, 1981

Helen C. Flanagan
Notary Public.

DRILLER'S LOG

COMPANY: Halliburton Oil Producing Co., 117 Cameron Bldg., Oklahoma City, Okla.
 CONTRACTOR: Hellar Drilling Company, Inc., Wichita, Kansas 67202 73106
 LEASE: #1 Lucas
 LOCATION: N/2 NE SE 4-24S-15W, Stafford County, Kansas
 COMMENCED: June 26, 1971
 COMPLETED: July 1, 1971
 CASING: Set 8 5/8" Surface Casing @ 250'/185 sacks cement
 Set 5 1/2" Casing @ 3129'/200 sacks cement (Used)

0-100	Clay & Sand
100-375	Shale
375-951	Shale - Red Bed
951-976	Anhydrite
976-1817	Shale & Shells
1817-1945	Shale
1945-2060	Lime
2060-2505	Lime & Shale
2505-2635	Lime
2635-2860	Lime - Shale
2860-3130	Lime
3130	Rotary Total Depth

RECEIVED
STATE CORPORATION COMMISSION

APR 28 1977

CONSERVATION DIVISION
Wichita, Kansas

STATE OF KANSAS)
) SS
 COUNTY OF SEDGWICK)

I, D. L. Hellar, do hereby certify that the above and foregoing is a true and correct copy of the log of the #1 Lucas, located in N/2 NE SE 4-24S-15W, Stafford County, Kansas, as reflected by the files of the Hellar Drilling Company, Inc.

HELLAR DRILLING COMPANY, INC.

By *D. L. Hellar*
 President - D. L. Hellar

Subscribed and sworn to before me, a Notary Public, in and for Sedgwick County, Kansas, this 8th day of July, 1971.

Catherine Darcey
 Notary Public - Catherine Darcey

My Commission Expires:

March 25, 1972.

