

Give All Information Completely
Make Required Affidavit
Mail or Deliver Report to:
Conservation Division
State Corporation Commission
211 No. Broadway
Wichita, Kansas

WELL PLUGGING RECORD

Stafford County, Sec. 13 Twp. 24S Rge. 14W (W)

Location as "NE/CNW/SW" or footage from lines SW SW SW

Lease Owner D. R. Lauck Oil Company, Inc. and Sunray DX Oil

Lease Name Asher Well No. 1 Company

Office Address 301 S. Broadway, Wichita, Kansas

Character of Well (completed as Oil, Gas or Dry Hole) Dry Hole

Date well completed September 20, 1962

Application for plugging filed September 20, 1962

Application for plugging approved September 20, 1962


Plugging commenced September 20, 1962

Plugging completed September 20, 1962

Reason for abandonment of well or producing formation Dry Hole

If a producing well is abandoned, date of last production -- 19---

Was permission obtained from the Conservation Division or its agents before plugging was commenced? Yes

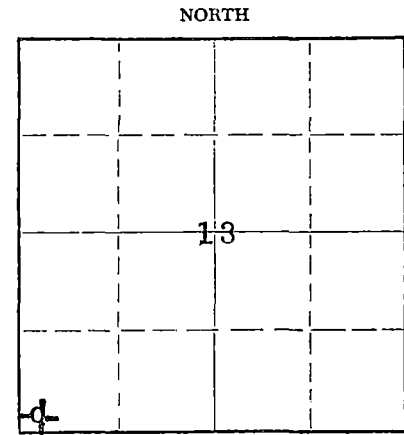

Locate well correctly on above Section Plat

Name of Conservation Agent who supervised plugging of this well Mr. Bill Lackamp

Producing formation _____ Depth to top _____ Bottom _____ Total Depth of Well 4000 Feet

Show depth and thickness of all water, oil and gas formations.

OIL, GAS OR WATER RECORDS

CASING RECORD

FORMATION	CONTENT	FROM	TO	SIZE	PUT IN	PULLED OUT
	201'	0	201'	8-5/8"	201'	None

Describe in detail the manner in which the well was plugged, indicating where the mud fluid was placed and the method or methods used in introducing it into the hole. If cement or other plugs were used, state the character of same and depth placed, from _____ feet to _____ feet for each plug set.

Hole filled with Mud 4000-190'
 Plug 190-186'
 20 sacks Cement & Mud 186- 35'
 Plug 35- 31'
 10 sacks Cement 31- 6' Bottom of Cellar

RECEIVED
STATE CORPORATION COMMISSION

SEP 25 1962

CONSERVATION DIVISION
Wichita, Kansas

(If additional description is necessary, use BACK of this sheet)

Name of Plugging Contractor Sun Cementing Co.
Address 301 S. Broadway, Wichita, Kansas

STATE OF KANSAS, COUNTY OF SEDGWICK, ss.

John H. Knightley (employee of owner) or (~~MANAGER~~) of the above-described well, being first duly sworn on oath, says: That I have knowledge of the facts, statements, and matters herein contained and the log of the above-described well as filed and that the same are true and correct. (So help me God.)

(Signature) John H. Knightley
301 S. Broadway, Wichita, Kansas
(Address)

SUBSCRIBED AND SWORN TO before me this 24th day of September, 19 62

My commission expires March 12, 1963

Stella J. Bodine
Stella J. Bodine Notary Public.

