

STATE OF KANSAS
STATE CORPORATION COMMISSION

Give All Information Completely
Make Required Affidavit
Mail or Deliver Report to:
Conservation Division
State Corporation Commission
800 Bitting Building
Wichita, Kansas

WELL PLUGGING RECORD

Stafford County. Sec. 13 Twp. 24S Rge. 14W (E) (W)

Location as "NE/CNW/SW" or footage from lines NE SE SE

Lease Owner Shell Oil Company

Lease Name P. Shell Well No. 1

Office Address 434 N. Oliver, Wichita, Kansas

Character of Well (completed as Oil, Gas or Dry Hole) Dry hole

Date well completed April 15 1954

Application for plugging filed April 15, 1954 1954

Application for plugging approved April 15 1954


Plugging commenced 4:00 p.m., April 15 1954

Plugging completed 11:30 p.m., April 15 1954

Reason for abandonment of well or producing formation Commercial quantity of oil not found

If a producing well is abandoned, date of last production 19

Was permission obtained from the Conservation Division or its agents before plugging was commenced? Yes

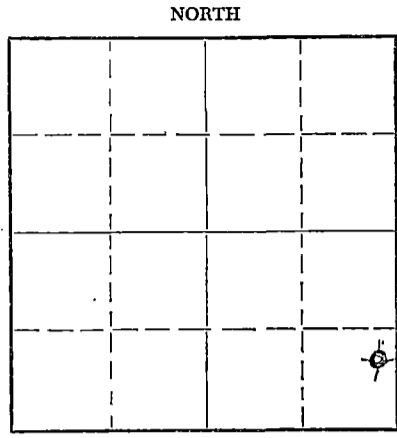

Locate well correctly on above Section Plat

Name of Conservation Agent who supervised plugging of this well C. D. Stough

Producing formation Depth to top Bottom Total Depth of Well 3950 Feet

Show depth and thickness of all water, oil and gas formations.

OIL, GAS OR WATER RECORDS

CASING RECORD

FORMATION	CONTENT	FROM	TO	SIZE	PUT IN	PULLED OUT
				8 5/8	816'	

Describe in detail the manner in which the well was plugged, indicating where the mud fluid was placed and the method or methods used in introducing it into the hole. If cement or other plugs were used, state the character of same and depth placed, from feet to feet for each plug set.

Set plug @ 300' put in 30 sacks cement
Set plug @ 40' put in 15 sacks cement

4-29-1954

RECEIVED
STATE CORPORATION COMMISSION
APR 29 1954
CONSERVATION DIVISION
Wichita, Kansas

(If additional description is necessary, use BACK of this sheet)

Name of Plugging Contractor K & E Drilling, Inc.
Address 1006 Central Building, Wichita, Kansas

STATE OF Kansas, COUNTY OF Sedgwick, ss.
Clinton Engstrand, agent for (employee of owner) or (owner or operator) of the above-described well, being first duly sworn on oath, says: That I have knowledge of the facts, statements, and matters herein contained and the log of the above-described well as filed and that the same are true and correct. So help me God.

(Signature) [Signature]
1006 Central Building, Wichita, Kans.
(Address)

SUBSCRIBED AND SWORN to before me this 27 day of April, 1954

[Signature] Notary Public.

My commission expires 10-29-55

PLUGGING
FILE SEC 13 T 24 R 14W
BOOK PAGE 27 LINE 45

SHELL OIL COMPANY
NO. 1 P. SHELL

NE SE SE Section 13-24S-14W
Stafford County, Kansas

Casing
8 5/8" Set @ 816'

Cement
425 Sacks

Comm: 4-1-54
Comp: 4-15-54
Total Depth: 3950'

FORMATION	DEPTH
Surface Sand & Clays	0 - 445
Red bed w/sand strks.	445 - 625
Red shale	625 - 811
Anhydrite	811 - 816
Anhydrite	816 - 840
Shale and shells	840 - 1266
Shale & shells	1266 - 1330
Sand - Shale strks.	1330 - 1545
Shale and shells	1545 - 1727
Shale and shells	1727 - 1780
Lime and shale	1780 - 1870
Lime and shale	1870 - 1970
Lime and shale	1970 - 2055
Lime and shale	2055 - 2220
Shale and lime	2220 - 2320
Shale and lime	2320 - 2410
Lime and shale	2410 - 2550
Shale	2550 - 2715
Shale, lime strks.	2715 - 2865
Lime and shale	2865 - 2945
Broken lime	2945 - 3075
Lime and shale	3075 - 3182
Lime and shale	3182 - 3248
Lime	3248 - 3448
Lime and shale	3448 - 3504
Shale and shells	3504 - 3565
Lime and shale	3565 - 3580
Broken lime	3580 - 3630
Lime dense	3630 - 3661
Lime	3661 - 3696
Lime	3696 - 3701
Lime	3701 - 3726
Lime	3726 - 3770
Lime	3770 - 3775
Lime dense	3775 - 3786
Lime	3787 - 3819
Lime	3819 - 3851
Broken lime and shale	3851 - 3861
Lime - shale	3861 - 3908
Conglomerate	3908 - 3950

STATE OF KANSAS)
) SS.
SEDGWICK COUNTY)

4-24-54

I hereby certify that the above information is true and correct to the best of my knowledge.

Walter J. [Signature]

Subscribed and sworn to before me this 27 day of April, 1954.

Walter J. [Signature]
Notary Public

My Commission Expires: 10-29-55

PLUGGING
WELL SEC 13-24-14W
PAGE 27 LINE 45