


STATE OF KANSAS
STATE CORPORATION COMMISSION

Give All Information Completely
Make Required Affidavit
Mail or Deliver Report to:
Conservation Division
State Corporation Commission
211 No. Broadway
Wichita, Kansas

WELL PLUGGING RECORD

Stafford County. Sec. 13 Twp. 24 Rge. (E) 14 (W)

Location as "NE/CNW%SW%" or footage from lines NE SE SE
Lease Owner D. R. Lauck Oil Co., Inc.
Lease Name Shell Well No. 1
Office Address 301 South Broadway, Wichita, Kansas 67202
Character of Well (completed as Oil, Gas or Dry Hole) Gas
Date well completed July 22 19 59
Application for plugging filed July 15 19 64
Application for plugging approved July 17 19 64
Plugging commenced July 23 19 64
Plugging completed July 27 19 64
Reason for abandonment of well or producing formation Depleted

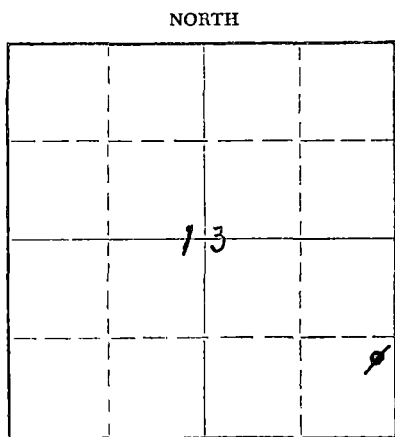

Locate well correctly on above
Section Plat

If a producing well is abandoned, date of last production June 28 19 64
Was permission obtained from the Conservation Division or its agents before plugging was commenced? Yes

Name of Conservation Agent who supervised plugging of this well Mr. Archie Elring
Producing formation Mississippi Depth to top 3908 Bottom 3916 Total Depth of Well 4007 Feet
Show depth and thickness of all water, oil and gas formations. PB 3970

OIL, GAS OR WATER RECORDS

CASING RECORD

FORMATION	CONTENT	FROM	TO	SIZE	PUT IN	PULLED OUT
Mississippi	Gas	3908	3916	8 5/8	233	None
				5 1/2	4007	3480

Describe in detail the manner in which the well was plugged, indicating where the mud fluid was placed and the method or methods used in introducing it into the hole. If cement or other plugs were used, state the character of same and depth placed, from feet to feet for each plug set.

Sand 3970 to 3900
5 sx. cement 3900 to 3870
Mud 3870 to 225
Rock Bridge 225 to 215
25 sx. cement 215 to 150
Mud 150 to 30
10 sx. cement 30 to base of cellar

RECEIVED
STATE CORPORATION COMMISSION

AUG 10 1964

CONSERVATION DIVISION
Wichita, Kansas

(If additional description is necessary, use BACK of this sheet)
Name of Plugging Contractor Glenn & Smith Pipe Pulling Co.
Address P. O. Box 156, Ellinwood, Kansas 67526

STATE OF Kansas, COUNTY OF Barton, ss.
H. E. Wolfe (employee of owner) or (owner or operator) of the above-described well, being first duly sworn on oath, says: That I have knowledge of the facts, statements, and matters herein contained and the log of the above-described well as filed and that the same are true and correct. So help me God.

(Signature) *H. E. Wolfe*
Box 156, Ellinwood, Kansas 67526
(Address)

SUBSCRIBED AND SWORN to before me this 6th day of August 19 64

My commission expires 8/21/65

Notary Public.

D. R. LAUCK OIL COMPANY, INC.

Shell #1
OWWO

^{SE}
NE ~~NE~~ SE Sec. 13-24S-14W
Stafford County, Kansas

Commenced: July 20, 1959

Completed: July 23, 1959

Casing Record: 816' 8 5/8" in hole
4007' 5 1/2" cemented with 600 gal. latex cement

Elevation: 1931 KB

Drillers Log

Plug and Cement	1000
Wash Down	3925
Shale	3996
Viola	4007 RTD

RECEIVED
STATE CORPORATION COMMISSION

JUL 17 1964

CONSERVATION DIVISION
Wichita, Kansas