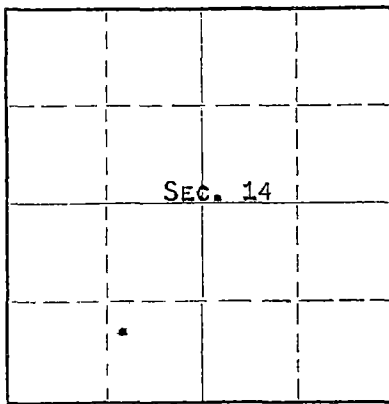


STATE OF KANSAS
STATE CORPORATION COMMISSION

Give All Information Completely
Make Required Affidavit
Mail or Deliver Report to:
Conservation Division
State Corporation Commission
211 No. Broadway
Wichita, Kansas

WELL PLUGGING RECORD

NORTH

Locate well correctly on above
Section Plat

STAFFORD County. Sec. 14 Twp. 24s Rge. 14 (E) (W)
Location as "NE/CNW/SW" or footage from lines APP. NW SE SW
Lease Owner PETROLEUM, INC.
Lease Name NEILL "D" Well No. 1
Office Address ROUTE #2, GREAT BEND, KANSAS
Character of Well (completed as Oil, Gas or Dry Hole) DRY HOLE
Date well completed AUGUST 12 19 65
Application for plugging filed AUGUST 12 19 65
Application for plugging approved AUGUST 12 19 65
Plugging commenced AUGUST 12 19 65
Plugging completed AUGUST 12 19 65
Reason for abandonment of well or producing formation NO PRODUCIBLE ZONE

If a producing well is abandoned, date of last production 19____
Was permission obtained from the Conservation Division or its agents before plugging was commenced? YES

Name of Conservation Agent who supervised plugging of this well ARCHIE ELVING
Producing formation _____ Depth to top _____ Bottom _____ Total Depth of Well 3619 Feet
Show depth and thickness of all water, oil and gas formations.

OIL, GAS OR WATER RECORDS

CASING RECORD

FORMATION	CONTENT	FROM	TO	SIZE	PUT IN	PULLED OUT
				8-5/8	215'	NONE

Describe in detail the manner in which the well was plugged, indicating where the mud fluid was placed and the method or methods used in introducing it into the hole. If cement or other plugs were used, state the character of same and depth placed, from _____ feet to _____ feet for each plug set.

MUDDED UP WITH HEAVY MUD TO 210', FOLLOWED BY WOODEN PLUG, PLACED 1/2 SACK HULLS AND 25 SACKS CEMENT THROUGH DRILL PIPE ON TOP OF PLUG. MUDDED UP WITH HEAVY MUD TO 40' FOLLOWED BY WOODEN PLUG, PLACED 1/2 SACK HULLS AND 10 SACKS CEMENT ON TOP OF PLUG TO BASE OF WELL CELLAR.

RECEIVED
STATE CORPORATION COMMISSION

AUG 19 1965

CONSERVATION DIVISION
Wichita, Kansas

8-19-65

(If additional description is necessary, use BACK of this sheet)
Name of Plugging Contractor GARVEY DRUG CO.
Address ROUTE #2, GREAT BEND, KANSAS

STATE OF KANSAS, COUNTY OF BARTON, ss.
MONTE CHADD (employee of owner) or (owner) of the above-described

well, being first duly sworn on oath, says: That I have knowledge of the facts, statements, and matters herein contained and the log of the above-described well as filed and that the same are true and correct. So help me God. MONTE CHADD, DIST. PROD. SUPT.

(Signature)

R.R. #2, GREAT BEND, KANSAS
(Address)

SUBSCRIBED AND SWORN to before me this 18 day of AUGUST, 19 65

My commission expires MAY 28, 1969

Notary Public.

WELL LOG

15-185-30087-0000

COMPANY Petroleum, Inc.

SEC. 14 T. 24S R. 14W

FARM Neill

NO. D-1

LOC. App NW-SE-SW


TOTAL DEPTH 3619'

COUNTY Stafford

COMM. 8-6-65

COMP. 8-12-65

CONTRACTOR Garvey Drilling Company

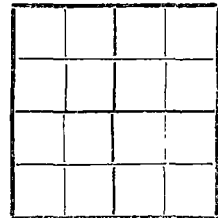

CASING 8 5/8" @ 215' w/250 sx

ELEVATION 1942' KB

PRODUCTION D & A

FIGURES INDICATE BOTTOM OF FORMATIONS

105' Sand and Shale
240' Shale
836' Red Bed and Shale
860' Anhydrite
950' Shale and Shells
1840' Shale and Lime Streaks
2435' Lime and Shale
2470' Shale
3138' Shale and Lime
3445' Lime and Shale
3619' Shale and Lime
3619' RTD

RECEIVED
STATE CORPORATION COMMISSION

AUG 19 1965

CONSERVATION DIVISION
Wichita, Kansas

8-19-65

State of, KansasCounty of Barton

SS

I, Sam N. Stephens of Garvey Drilling Companyupon oath state the above and foregoing is a true and correct copy of the log of the Neill D-1 well.

Sam N. Stephens

Subscribed and sworn to before me this 17th day of August 19 65My Commission Expires: May 28, 1969

Richard H. Drunker
NOTARY PUBLIC