


STATE OF KANSAS
STATE CORPORATION COMMISSION

WELL PLUGGING RECORD

Give All Information Completely
Make Required Affidavit
Mail or Deliver Report to:
Conservation Division
State Corporation Commission
800 Bitting Building
Wichita, Kansas

Stafford County. Sec. 14 Twp. 24 Rge. 14 (#) (W)
Location as "NE/CNW $\frac{1}{4}$ SW $\frac{1}{4}$ " or footage from lines SW SW SE
Lease Owner Shell Oil Company
Lease Name W. E. MILLER "A" Well No. 2
Office Address Box 744, Great Bend, Kansas
Character of Well (completed as Oil, Gas or Dry Hole) Dry Hole
Date well completed October 28 19 50
Application for plugging filed January 16 19 51
Application for plugging approved January 19 19 51
Plugging commenced January 27 19 51
Plugging completed February 8 19 51
Reason for abandonment of well or producing formation Dry Hole

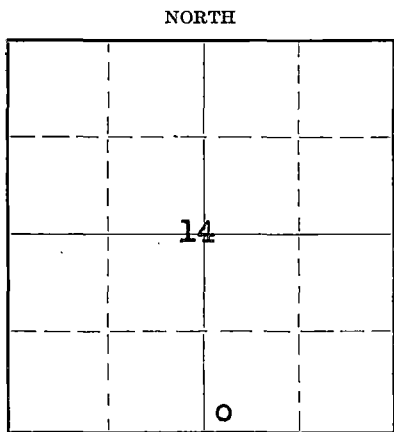

Locate well correctly on above
Section Plat

If a producing well is abandoned, date of last production - 19 -
Was permission obtained from the Conservation Division or its agents before plugging was commenced? Yes

Name of Conservation Agent who supervised plugging of this well C. D. Stough
Producing formation Lans-Kans City Depth to top 3617 Bottom - Total Depth of Well 3886 Feet
Show depth and thickness of all water, oil and gas formations. 3680 PB

OIL, GAS OR WATER RECORDS

CASING RECORD

Formation	Content	From	To	Size	Put In	Pulled Out
Lansing-Kansas City	68 gal salt			8 5/8"	822'	None
	wtr/hr	3817	3824	4 1/2"	3885'	3086'
	3 1/2 bbl salt					
	wtr/hr	3774	3780			
	64 bbl salt					
	wtr in 6 hrs					
	w/ faint trace					
	oil last 3 hrs.	3636	3651			

Describe in detail the manner in which the well was plugged, indicating where the mud fluid was placed and the method or methods used in introducing it into the hole. If cement or other plugs were used, state the character of same and depth placed, from _____ feet to _____ feet for each plug set.

Plugged back with chat to 3600 & dumped 4
sax cement to 3560. Mudded hole & pumped
200 sax bulk cement in 8 5/8" OD surface
casing to 45'. Mudded hole to 15' & dumped
5 sax cement to top.

2-21-51

RECEIVED
STATE CORPORATION COMMISSION

FEB 21 1951

CONSERVATION DIVISION
WICHITA, KANSAS

(If additional description is necessary, use BACK of this sheet)

Correspondence regarding this well should be addressed to Shell Oil Company
Address c/o S. S. Mabry, Box 744, Great Bend, Kansas

STATE OF KANSAS, COUNTY OF BARTON, ss.

S. S. Mabry (employee of owner) or ~~owner~~ of the above-described well,
being first duly sworn on oath, says: That I have knowledge of the facts, statements, and matters herein contained and the log of the above-described well as filed and that the same are true and correct. So help me God.

(Signature) S. S. Mabry
Box 744, Great Bend, Kansas
(Address)

SUBSCRIBED AND SWORN to before me this 19th day of February, 19 51

Betty Postlethwaite
Notary Public.

My commission expires January 24, 1953

PLUGGING
FILE SEC 14 T 24 R 14 W
BOX FILE 56 LINE 29

SHELL-W. E. MILLER "A" #2
 SW SW SE 14-24S-14W
 Rattlesnake, S. W. Field
 Stafford County, Kansas

Casing Record

8 5/8" cem 822 with 400 sax
 4 1/2" cem 3885 with 150 sax

- 0 - 210 surface clay, shale & sand
- 440 shale
- 495 sand
- 808 red & gray shale
- 838 anhydrite
- 1255 shale & lime
- 1340 salt, shale, anhydrite & gypsum
- 1840 shale & lime
- 2040 lime w/ shale streaks
- 2210 lime & shale
- 2430 lime
- 2950 shale & lime
- 3015 sand & shale
- 3045 shale & lime
- 3140 lime
- 3165 lime & shale, streak chert
- 3175 lime, anhydrite & shale
- 3187 lime Top Topeka 3187
- 3191 lime
- 3201 lime, anhydritic, siliceous, conglomeratic
- 3215 lime, anhydritic & shale
- 3230 lime, w/ chert & shale
- 3247 lime, shale & chert streaks
- 3275 shale & lime
- 3304 shale & lime streaks
- 3322 lime & shale
- 3346 lime, shale & sand streaks
- 3355 sand, lime & shale, chert streaks
- 3373 lime, sand, chert shale
- 3387 lime, sandy, shaly, chert streaks
- 3395 lime, shale streaks
- 3406 lime, sand chert streaks
- 3415 lime, dolomite streaks, shale
- 3426 lime & shale streaks
- 3442 lime, chert streaks
- 3454 lime, shale
- 3459 shale Top Heebner 3454
- 3593 lime & shale Top Tatan 3593
- 3598 lime, shaley
- 3615 shale & shaley lime
- 3620 lime, shaley Top Lans-Kans City 3620
- 3631 lime, shale streaks
- 3635 lime
- 3649 lime
- 3657 lime, streaks shale
- 3661 lime
- 3688 lime, shale & chert streaks
- 3697 lime
- 3703 lime, chert streaks

Perforations: 3608-09
 3636-51
 3774-80
 3817-24

RECEIVED
 CORPORATION COMMISSION
 JAN 19 1951
 CONSERVATION DIVISION
 WICHITA, KANSAS
 FILE SEC. 147-26 R (14)
 BOOK PAGE 56 LINE 29

1-19-51

3710 lime, shale, chert
 3738 lime & chert
 3747 lime
 3752 lime & shale streaks
 3758 lime & shale
 3771 lime & shale streaks
 3799 lime
 3810 lime, streaks shale
 3819 lime & shale
 3849 lime & shale
 3855 lime & shale
 3862 lime, shale streaks
 3886 lime & shale, chert streaks TD
 3680 PB - 3886-3842 1/2 cement;
 set bridging plug 3799 1/2;
 set bridging plug 3680;
 set magnesium bridging plug 3620 &
 drove to 3675.

1710-11
 1911
 1912
0 - 310



