


STATE OF KANSAS
STATE CORPORATION COMMISSION

WELL PLUGGING RECORD

Give All Information Completely.
Make Required Affidavit
Mail or Deliver Report to
Conservation Division
State Corporation Comm.
245 North Water
Wichita, KS 67202

Stafford County. Sec. 20 Twp. 24 Rge. 14W E/W
Location as "NE/CNW $\frac{1}{4}$ SW $\frac{1}{4}$ " or footage from lines
SW SW SW

Lease Owner The Roxana Corporation
Lease Name Ulsh Well No. 1
Office Address Box 1162 Great Bend, Kansas 67530
Character of Well (Completed as Oil, Gas or Dry Hole)

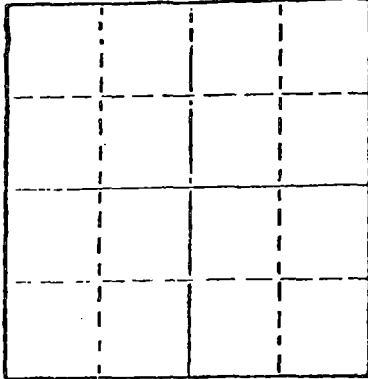

Locate well correctly on above
Section Plot

Date Well completed March 14 19 80
Application for plugging filed March 14 19 80
Application for plugging approved March 14 19 80
Plugging commenced March 14 19 80
Plugging completed March 14 19 80
Reason for abandonment of well or producing formation

If a producing well is abandoned, date of last production 19

Was permission obtained from the Conservation Division or its agents before plugging was commenced? Yes

Name of Conservation Agent who supervised plugging of this well Wm. T. Owen
Producing formation Depth to top Bottom Total Depth of Well
Show depth and thickness of all water, oil and gas formations.

OIL, GAS OR WATER RECORDS

CASING RECORD

FORMATION	CONTENT	FROM	TO	SIZE	PUT IN	PULLED OUT
				8 5/8	338	

Describe in detail the manner in which the well was plugged, indicating where the mud fluid was placed and the method or methods used in introducing it into the hold. If cement or other plugs were used, state the character of same and depth placed, from feet to feet for each plug set.

35 sx. @ 600'

40 sx. @ 330'

plug & 10 sx. @ 40'

5 sx, in the rathole

3-19-80

RECEIVED
STATE CORPORATION COMMISSION
MAR 19 1980

(If additional description is necessary, use BACK of this sheet)

Name of Plugging Contractor Woodman & Iannitti Drilling Co.

STATE OF KANSAS COUNTY OF SEDGWICK
K. T. Woodman (employee of owner) or (owner or operator)


of the above-described well, being first duly sworn on oath, says: That I have knowledge of the facts, statements, and matters herein contained and the log of the above-described well as filed and that the same are true and correct. So help me God.

(Signature) K. T. Woodman
1008 Douglas Bldg. 104 S. Broadway
(Address)

SUBSCRIBED AND SWORN TO before me this 18th day of March, 19 80

My commission expires Feb. 11, 1984

Justina Chamberlain
Notary Public.
Justina Chamberlain

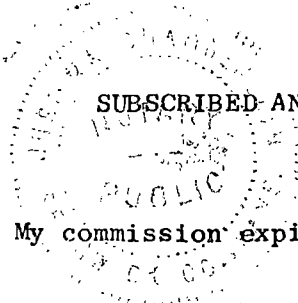

K. T. WOODMAN
RES. PHONE 733-0418
OFF. PHONE 265-7650
WICHITA, KANSAS**WOODMAN & IANNITTI DRILLING COMPANY**
*Rotary Drilling Contractors*1008 DOUGLAS BUILDING
104 S. BROADWAY
WICHITA, KANSAS 67202

March 18, 1980

Company;	The Roxana Corporation
Farm;	#1 U1sh
Location;	SW SW SW
Section;	20-24-14W
County;	Stafford
Contractor;	Woodman & Iannitti Drilling Co.
Total Depth;	4453
Comm;	March 6, 1980
Compl;	March 14, 1980
Casing;	8 5/8 @ 338' w/235 sx
Production;	D & A

Figures Indicate Bottom Of Formation

338	Sand & shale
946	Shale & sand
967	Anhydrite
1301	Shale
2160	Shale
2460	Shale w/lime streaks
2790	Shale & lime
3010	Shale
3230	Shale & lime
3435	Shale & lime
3590	Lime
4141	Lime
4159	Mississippi
4280	Lime
4453	Lime R.T.D.

I certify the above to be a true and correct copy of the drillers log to the best of my knowledge and belief.

Woodman & Iannitti Drilling Co.

K. T. Woodman
K. T. Woodman
RECEIVED
CORPORATION COMMISSION

MAR 19 1980
CONSERVATION DIVISION
Wichita, Kansas