


Give All Information Completely  
Make Required Affidavit  
Mail or Deliver Report to:  
Conservation Division  
State Corporation Commission  
212 No. Market  
Wichita, Kansas

WELL PLUGGING RECORD

NORTH

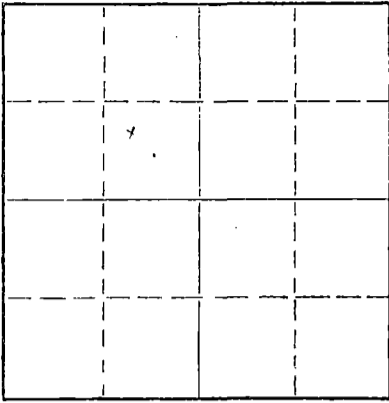

Locate well correctly on above  
Section Plat

Sedgwick County. Sec. 33 Twp. 29S Rge. (E) 2 (W)  
Location as "NE/CNW/SW" or footage from lines NW SE NW  
Lease Owner Chief Drilling, Inc.  
Lease Name Leland Daley Well No. 1  
Office Address 3175 Cleveland Avenue, Columbus, Ohio  
Character of Well (completed as Oil, Gas or Dry Hole) Dry Hole  
Date well completed Aug. 16, 1968  
Application for plugging filed Aug. 26, 1968  
Application for plugging approved (phone 8/16/68) Aug. 16, 1968  
Plugging commenced Aug. 16, 1968  
Plugging completed Aug. 16, 1968  
Reason for abandonment of well or producing formation \_\_\_\_\_

If a producing well is abandoned, date of last production \_\_\_\_\_ 19\_\_\_\_  
Was permission obtained from the Conservation Division or its agents before plugging was commenced? Yes

Name of Conservation Agent who supervised plugging of this well Ted Dewey  
Producing formation \_\_\_\_\_ Depth to top \_\_\_\_\_ Bottom \_\_\_\_\_ Total Depth of Well 3175 Feet  
Show depth and thickness of all water, oil and gas formations.

OIL, GAS OR WATER RECORDS

CASING RECORD

FORMATION	CONTENT	FROM	TO	SIZE	PUT IN	PULLED OUT
		0	250	8-5/8"	250	None

Describe in detail the manner in which the well was plugged, indicating where the mud fluid was placed and the method or methods used in introducing it into the hole. If cement or other plugs were used, state the character of same and depth placed, from \_\_\_\_\_ feet to \_\_\_\_\_ feet for each plug set.

Filled hole with mud to 250 feet, set first plug @ 250 feet with 1/2 sack hulls and 25 sacks cement. Filled hole with mud to 40 feet, set second plug @ 40 feet with 1/2 sack hulls and 10 sacks cement. Plugged rat hole with 2 sacks cement. Job complete @ 6:00 P.M., Aug. 16, 1968.

RECEIVED  
STATE CORPORATION COMMISSION  
AUG 28 1968  
CONSERVATION DIVISION  
Wichita, Kansas

(If additional description is necessary, use BACK of this sheet)

Name of Plugging Contractor Gabbert-Jones, Inc.  
Address 830 Sutton Place, Wichita, Kansas 67202


STATE OF Kansas, COUNTY OF Sedgwick, ss.  
E. E. HALL (employee of owner) or (owner or operator) of the above-described well, being first duly sworn on oath, says: That I have knowledge of the facts, statements, and matters herein contained and the log of the above-described well as filed and that the same are true and correct. So help me God.

(Signature) E E Hall  
830 Sutton Place, Wichita, Kansas 67202  
(Address)

SUBSCRIBED AND SWORN TO before me this 26 day of August, 19 68

Barbara J. Layton  
Barbara J. Layton, Notary Public.

Feb. 1, 1972

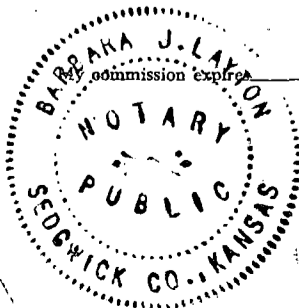

GABBERT-JONES, INC.  
WICHITA, KANSAS  
DRILLERS' WELL LOG

LELAND DALEY #1  
NW SE NW Section 33-29S-2W  
Sedgwick County, Kansas

Commenced: August 8, 1968  
Completed: August 16, 1968

OPERATOR - Chief Drilling, Inc.

DEPTH		FORMATION	REMARKS
From	To		
0	250	Shale and shells	Ran 14 joints 8-5/8" casing, set @ 250' w/200 sacks cement.
250	575	Shale and shells	
575	2510	Lime and shale	
2510	2803	Lime and shaley sand	
2803	2880	Sand and shale	
2880	3006	Lime and shale	
3006	3175	Lime	Dry and abandoned.
3175	TD		

I, E. E. HALL, certify this is a correct copy of the Drillers' Log for the well drilled in the NW SE NW Section 33-29S-2W, Sedgwick County, Kansas, to the best of my knowledge and belief.

*E. E. Hall*

E. E. HALL

STATE OF KANSAS )  
 ) SS  
COUNTY OF SEDGWICK )

Before me, the undersigned, a Notary Public within and for said County and State, on this 26th day of August, 1968, personally appeared E. E. HALL, to me personally known to be the identical person who executed the within and foregoing instrument and acknowledged to me that he executed the same as his free and voluntary act and deed for the uses and purposes therein set forth.

IN WITNESS WHEREOF, I have hereunto set my hand and official seal the day and year last above written.

*Barbara J. Layton*  
Barbara J. Layton, Notary Public

My Commission Expires February 1, 1972.

