

WELL PLUGGING RECORD

Give All Information Completely  
Make Required Affidavit  
Mail or Deliver Report to:  
Conservation Division  
State Corporation Commission  
211 No. Broadway  
Wichita, Kansas

Clark County, Sec. 35 Twp. 32 Rge. 23 (E) (W)

Location as "NE/CNW/SW" or footage from lines 0 SE SE

Lease Owner Amarillo Natural Gas Co. Well No. 2

Lease Name Well Office Address 305 Bank ~~Sw~~ Southwest Amarillo Texas

Character of Well (completed as Oil, Gas or Dry Hole) m

Date well completed 19

Application for plugging filed 19

Application for plugging approved June 12- 19 67


Plugging commenced 6/20 19 67

Plugging completed 6/22 19 67

Reason for abandonment of well or producing formation

If a producing well is abandoned, date of last production 19

Was permission obtained from the Conservation Division or its agents before plugging was commenced? Yes

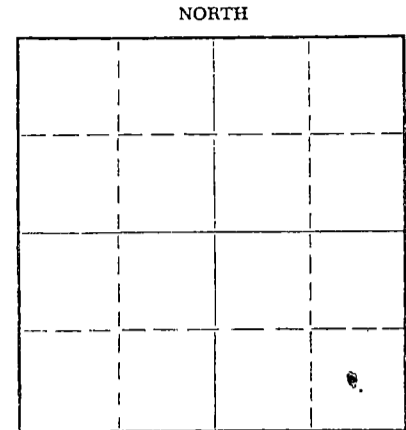

Locate well correctly on above Section Plat

Name of Conservation Agent who supervised plugging of this well Ed Eves

Producing formation Depth to top Bottom Total Depth of Well 4452 Feet

Show depth and thickness of all water, oil and gas formations.

OIL, GAS OR WATER RECORDS

CASING RECORD

FORMATION	CONTENT	FROM	TO	SIZE	PUT IN	PULLED OUT
	13-3/8"	0	200	13-3/8	200	None
	8-5/8	0	571	8-5/8	571	None
	4-1/2	0	4451	4-1/2	4451	3192.90

Describe in detail the manner in which the well was plugged, indicating where the mud fluid was placed and the method or methods used in introducing it into the hole. If cement or other plugs were used, state the character of same and depth placed, from feet to feet for each plug set.

Mix 15 sks. cement to plug off perforations. Also squeezed off at 3180<sup>32</sup> Laid down 79 jnts. Circulate gell at 650'. Laid down 4 jnts casing. Pump 40 sks. cement at 550' to 450'. Laid down all casing ( 100 jnts. in all). Bridge and 10 sks. cement at 40' to 0.

FILED  
JUN 26 1967  
CONSERVATION DIVISION  
WICHITA, KANSAS

6-26-1967

(If additional description is necessary, use BACK of this sheet)  
Name of Plugging Contractor Sargent's Casing Pulling Service  
Address Box 506, Liberal, Kansas

STATE OF KANSAS, COUNTY OF SEWARD, ss.  
William F. Dean (employee of owner) or (owner or operator) of the above-described well, being first duly sworn on oath, says: That I have knowledge of the facts, statements, and matters herein contained and the log of the above-described well as filed and that the same are true and correct. So help me God.

(Signature) William F. Dean  
Liberal, Kansas (Address)

SUBSCRIBED AND SWORN TO before me this 24 day of June, 19 67

George W. Carnahan Jr Notary Public.

My commission expires January 24/1968

GABRIEL-JONES, INC.  
WICHITA, KANSAS  
DRILLERS' WELL LOG

RECEIVED  
 STATE CORPORATION COMMISSIONER

JUN 12 1967

CONSERVATION DIVISION  
 Wichita, Kansas

WELL #2  
 C SE SE Section 35-32S-23W  
 Clark County, Kansas

Commenced: August 25, 1966  
 Completed: September 4, 1966

OPERATOR- Amarillo Natural Gas Company

DEPTH		FORMATION	REMARKS
From	To		
0	70	Clay	
70	150	Sand	
150	197	Red Bed	Ran 5 joints of 13 3/8" casing set @ 197' w/250 sacks cement.
197	350	Red Bed	
350	570	Dry drill (no returns)	Ran 14 joints 8 5/8" casing set @ 570' w/350 sacks cement.
570	722	Red Bed	
700	1450	Red Bed and Shale	
1450	2170	Shale	
2170	2330	Shale and Lime	
2330	2750	Lime	
2750	4390	Lime and Shale	
4390	4452	Lime	
4452	TD		Ran 141 joints 4 1/2" casing set @ 4451' w/100 sacks cement.

I, E. E. HALL, certify this is a correct copy of the Drillers' Log for the well drilled in the C SE SE Section 35-32S-23W, Clark County, Kansas, to the best of my knowledge and belief.

E. E. Hall  
 E. E. HALL

STATE OF KANSAS )  
 ) SS  
 COUNTY OF SEDGWICK )

Before me, the undersigned, a Notary Public within and for said County and State, on this 9th day of September, 1966 personally appeared E. E. HALL, to me personally known to be the identical person who executed the within and foregoing instrument and acknowledged to me that he executed the same as his free and voluntary act and deed for the uses and purposes therein set forth.

IN WITNESS WHEREOF, I have hereunto set my hand and official seal the day and year last above written.

Jean S. Taylor  
 Jean S. Taylor, Notary Public

My Commission Expires June 28, 1970.