


WELL PLUGGING RECORD

Give All Information Completely
Make Required Affidavit
Mail or Deliver Report to:
Conservation Division
State Corporation Commission
211 No. Broadway
Wichita, Kansas

NORTH

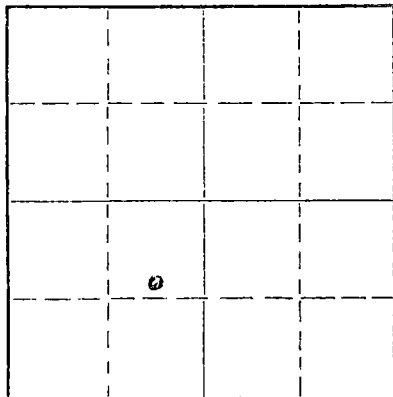

Locate well correctly on above
Section Plat

Clark County. Sec. 35 Twp. 32 Rge. 23 (E) (W)
Location as "NE/CNW/SW" or footage from line 260 S of N. 1/2 line 660 East
Lease Owner Amarillo, Natural Gas Company
Lease Name Abell Well No. 1-A
Office Address 305 Bank of Southwest Bldg. Amarillo, Texas
Character of Well (completed as Oil, Gas or Dry Hole) Oil
Date well completed 8-10 1965
Application for plugging filed 11-17 1966
Application for plugging approved 11-14 1966
Plugging commenced 11-17 1966
Plugging completed 11-18 1966
Reason for abandonment of well or producing formation Underground land slide breaking 4 1/2" casing & unable to produce well.
If a producing well is abandoned, date of last production 11-16 1966
Was permission obtained from the Conservation Division or its agents before plugging was commenced? Yes

Name of Conservation Agent who supervised plugging of this well Edgar Eves
Producing formation Laning Kansas City Depth to top 4452 Bottom 4478 Total Depth of Well 4750 Feet
Show depth and thickness of all water, oil and gas formations.

OIL, GAS OR WATER RECORDS

CASING RECORD

FORMATION	CONTENT	FROM	TO	SIZE	PUT IN	PULLED OUT
		0	568	8-5/8"	568	None
		0	4750	4-1/2"	4749	None

Describe in detail the manner in which the well was plugged, indicating where the mud fluid was placed and the method or methods used in introducing it into the hole. If cement or other plugs were used, state the character of same and depth placed, from _____ feet to _____ feet for each plug set.

Spot 100 Sacks cement thru 2" tubing at 4250' filling 4 1/2" casing to 2750'
Pumped 200 sacks cement down from top thru 8-5/8" casing & 4 1/2" casing
Plugging well from surface to 700' cementing done by Halliburton.

RECEIVED
STATE CORPORATION COMMISSION

NOV 21 1966

CONSERVATION DIVISION
Wichita, Kansas

(If additional description is necessary, use BACK of this sheet)

Name of Plugging Contractor Mahoney Drilling Company Inc.
Address Box 1257 Liberal, Kansas 67901

STATE OF Kansas, COUNTY OF Seward, ss.

T. W. Mahoney (employee of owner) or (owner or operator) of the above-described well, being first duly sworn on oath, says: That I have knowledge of the facts, statements, and matters herein contained and the log of the above-described well as filed and that the same are true and correct. So help me God.

(Signature) T. W. Mahoney
Box 1257 Liberal, Kansas (Address)

SUBSCRIBED AND SWORN TO before me this 18 day of November, 1966

My commission expires January 24, 1968

George W. Carnahan Jr
Notary Public.

ADRIEL A*1
E 1/2 of SW 1/4
Sec. 39-323-23W
Clark, County, Kansas

SRT 8-5/8" @968' 325 Sx Cement

Bot 4-1/2" @4750' 150 Sx Cement

RED Bed
Red Bed-Shale-Anhydrite
Shale-Anhydrite-Red Bed
Shale-Anhydrite
Lime-Shale
Lime
Lime-Shale
Lime
R.D.

0-580
580-1065
1065-1465
1465-2385
2385-3500
3500-3611
3611-4610
4610-4750
4750

THIS IS A TRUE AND EXACT COPY OF THE FORMATIONS
TAKEN FROM THE DAILY DRILLING REPORTS

Paul Dwight

D

STATE OF KANSAS

COUNTY OF SEWARD

SWORN TO BEFORE ME THIS 31 DAY OF July, 1966

George W. Cannahan, Jr.

GEORGE W. CANNAHAN, JR.
NOTARY PUBLIC

MY COMMISSION EXPIRES JANUARY 24, 1968

RECEIVED
STATE CORPORATION COMMISSION
NOV 21 1966
CONSERVATION DIVISION
Wichita, Kansas