

WELL PLUGGING RECORD

Give All Information Completely  
Make Required Affidavit  
Mail or Deliver Report to:  
Conservation Division  
State Corporation Commission  
211 No. Broadway  
Wichita, Kansas

Clark County. Sec. 35 Twp. 32 Rge. 23 (E) W (W)

Location as "NE/CNWxSWx" or footage from lines C-SE NE

Lease Owner Bovaird Supply Company

Lease Name Wall Well No. 3

Office Address P.O. Box 2590, Tulsa, Oklahoma 74102

Character of Well (completed as Oil, Gas or Dry Hole) Oil

Date well completed 9-7 19 67

Application for plugging filed 8-12 19 68

Application for plugging approved 8-23 19 68


Plugging commenced August 19 19 68

Plugging completed August 22 19 68

Reason for abandonment of well or producing formation Non-productive

If a producing well is abandoned, date of last production March 19 67

Was permission obtained from the Conservation Division or its agents before plugging was commenced? Yes

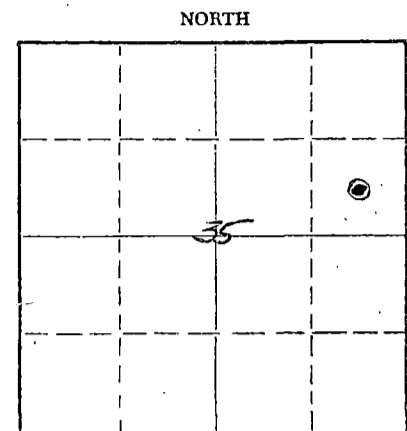

Locate well correctly on above Section Plat

Name of Conservation Agent who supervised plugging of this well E. Eves

Producing formation \_\_\_\_\_ Depth to top \_\_\_\_\_ Bottom \_\_\_\_\_ Total Depth of Well 6640 Feet

Show depth and thickness of all water, oil and gas formations.

OIL, GAS OR WATER RECORDS

CASING RECORD

FORMATION	CONTENT	FROM	TO	SIZE	PUT IN	PULLED OUT

Describe in detail the manner in which the well was plugged, indicating where the mud fluid was placed and the method or methods used in introducing it into the hole. If cement or other plugs were used, state the character of same and depth placed, from \_\_\_\_\_ feet to \_\_\_\_\_ feet for each plug set.

Pump 35 sks. cement at 584' to 484'.  
Displace with gell.  
15 sks. cement at 45' to 0'.

9-10-1968  
RECEIVED  
STATE CORPORATION COMMISSION  
SEP 10 1968  
CONSERVATION DIVISION  
Wichita, Kansas

(If additional description is necessary, use BACK of this sheet)

Name of Plugging Contractor Sargents Casing Pulling Service

Address Liberal, Kansas

STATE OF Kansas, COUNTY OF Seward, ss.

I, J. A. Peterson (employee of owner) or (owner or operator) of the above-described

well, being first duly sworn on oath, says: That I have knowledge of the facts, statements, and matters herein contained and the log of the above-described well as filed and that the same are true and correct. So help me God!


(Signature) J. A. Peterson

(Address)

SUBSCRIBED AND SWORN to before me this 9th day of September, 1968.

My commission expires January 31, 1971

Notary Public.

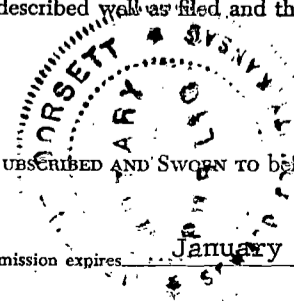

DRILLING LOG

LEASE OWNER Amarillo Natural Gas Co. ADDRESS Amarillo, Texas 79109  
LEASE Wall # 3 COUNTY Clark DESCRIPTION C SE NE Sec. 35-32S-23W

CASING: SIZE 8-5/8 WEIGHT 24# AMOUNT 582 KB

CEMENT: AMOUNT 400 Sx. CIRCULATED: Yes X No

CASING: SIZE 4 1/2 WEIGHT 10.5 AMOUNT 300

CEMENT: AMOUNT Sx. CIRCULATED: Yes No

PLUG SET: Ft. TO Ft. CEMENT Sx.

Ft. TO Ft. CEMENT Sx.

RECEIVED  
STATE CORPORATION COMMISSION  
AUG 26 1968  
CONSERVATION DIVISION  
Wichita, Kansas

FORMATION AND DEPTH

Sand-Red Bed-Gyp	0	TO 582
Red Bed- Shale	582	TO 1767
Red Bed-Shale-Anhydrite	1767	TO 2197
Shale-Anhydrite	2197	TO 2298
Lime-Shale	2298	TO 4527
Lime	4527	TO 6640
Total Depth	6640	TO
		TO
		TO
		TO
		TO
		TO
		TO
		TO
		TO
		TO
		TO

THIS IS A TRUE AND EXACT COPY OF THE FORMATIONS TAKEN FROM THE DAILY DRILLING REPORTS.

Executed this 12 day of August 19 67

By T. W. Maloney

IN WITNESS WHEREOF, I have hereunto set my hand and affixed my official seal the day and year above written.

George W. Carnahan Jr  
Notary Public

MY COMMISSION EXPIRES January 24, 1967

