


Give All Information Completely
Make Required Affidavit
Mail or Deliver Report to:
Conservation Division
State Corporation Commission
211 No. Broadway
Wichita, Kansas

WELL PLUGGING RECORD

Clark County, Sec. 35 Twp. 32 Rge. 23W (E) (W)

Location as "NE/CNW/SW" or footage from lines SE NW
Lease Owner Amarillo Natural Gas Co.
Lease Name Schrewder Well No. 1
Office Address 305 Bank of Southwest, Amarillo, Texas
Character of Well (completed as Oil, Gas or Dry Hole) Dry
Date well completed May 10 19 66
Application for plugging filed June 10 19 67
Application for plugging approved June 12- 19 67
Plugging commenced June 22 19 67
Plugging completed June 24 19 67
Reason for abandonment of well or producing formation Dry Hole

NORTH

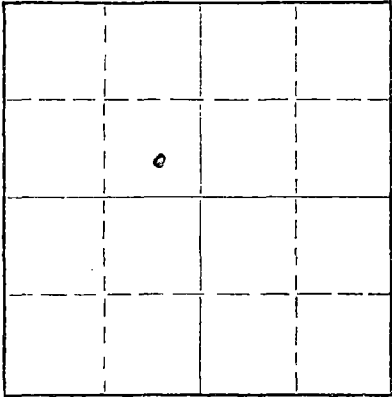

Locate well correctly on above
Section Plat

If a producing well is abandoned, date of last production 19
Was permission obtained from the Conservation Division or its agents before plugging was commenced? Yes Ed. Eves

Name of Conservation Agent who supervised plugging of this well
Producing formation Depth to top Bottom Total Depth of Well 4540 Feet
Show depth and thickness of all water, oil and gas formations.

OIL, GAS OR WATER RECORDS

CASING RECORD

FORMATION	CONTENT	FROM	TO	SIZE	PUT IN	PULLED OUT
	Surface	0	574	8-5/8	574	None
	Casing	0	4539	4-1/2	4539	3680

Describe in detail the manner in which the well was plugged, indicating where the mud fluid was placed and the method or methods used in introducing it into the hole. If cement or other plugs were used, state the character of same and depth placed, from feet to feet for each plug set.

Mix 10 sks. cement and 1 sk. hulls to plug off bottom perforations. Stopped plug at 4300'. Shot pipe at 3662' and worked same loose; lay down 65 jnts. Lay down casing to 650' and circulated gell. Lay down 4 jnts. and pump 40 sks. cement at 550' to 450'. Lay down all casing, 114 jnts. in all. Filled hole with mud to 40'. Put bridge and 10 sks. cement at 40' to 0.

7-5-1967

RECEIVED
STATE CORPORATION COMMISSION
JUL 5 1967

CONSERVATION DIVISION
WICHITA, KANSAS

(If additional description is necessary, use BACK of this sheet)
Name of Plugging Contractor Sargent's Casing Pulling Service
Address Box 506, Liberal, Kansas

STATE OF KANSAS, COUNTY OF SEWARD, ss.
L.E. Jeffery (employee of owner) or (owner or operator) of the above-described well, being first duly sworn on oath, says: That I have knowledge of the facts, statements, and matters herein contained and the log of the above-described well as filed and that the same are true and correct. So help me God.

(Signature) [Signature]
305 Bank of the Southwest (Address) Amarillo, Texas 79109

SUBSCRIBED AND SWORN TO before me this 3rd day of July, 1967
[Signature] Notary Public.

My commission expires 6-1-69

15-025-30068-0000

Shrewder # 1
Section 35-32S-23W
Clark County, Kansas

Set 8-5/8" 574' KB 350 Sx Cement
cement did circulate
Set 4-1/2" 4539 KB 150 Sx Cement

Clay
Red Bed-Sand
Red Bed
Red Bed-Gyp
Red Bed-Shale
Lime-Shale
TD

0-225
225-575
575-600
600-975
975-2265
2265-4540
4540

RECEIVED
OIL & GAS CONSERVATION COMMISSION
JUN 12 1966
6-12-67
CONSERVATION DIVISION
Wichita, Kansas

This is a true and exact copy of the formation taken from
The Daily Drilling Reports.

T. W. Mahoney
T. W. Mahoney, President

STATE OF KANSAS
COUNTY ~~OF~~ OF SEWARD

Sworn to before me this 14 Day of April, 1966

George W. Carnahan, Jr.
George W. Carnahan, Jr.
Notary Public

My commission expires January 24, 1968

Shrewder # 1
Section 35 32S-23W
Clark County, Kansas

Set 8-5" 574' KB 350 Sx Cement
cement did circulate
Set 4-1/2" 4539 KB 150 Sx Cement

Clay
Red Bed-Sand
Red Bed
Red Bed-Gyp
Red Bed-Shale
Lime-Shale
TD

0-225
225-575
575-600
600-975
975-2265
2265-4540
4540

This is a true and exact copy of the formation taken from
The Daily Drilling Reports.

T. W. Mahoney
T. W. Mahoney, President.

STATE OF KANSAS
COUNTY OF SEWARD

Sworn to before me this 14 Day of April, 1966

George W. Carnahan, Jr.
George W. Carnahan, Jr.
Notary Public

My commission expires January 24, 1968

RECEIVED
STATE CORPORATION COMMISSION
JUL 5 1967
CONSERVATION DIVISION
Wichita, Kansas