

STATE OF KANSAS
STATE CORPORATION COMMISSION

Form CP-4


Give All Information Completely
Make Required Affidavit
Mail or Deliver Report to:
Conservation Division
State Corporation Commission
212 No. Market
Wichita, Kansas

WELL PLUGGING RECORD

NOV 1 1968
RECORDED

Clark County, Sec. 35 Twp. 32 Rge. 23W (SE) NW (W)

Location as "NE/CNW/SW" or footage from lines
Lease Owner Republic Natural Gas
Lease Name Shrewder Well No. 1
Office Address Box 98 Hugoton, Kansas
Character of Well (completed as Oil, Gas or Dry Hole) depleted Oil
Date well completed May 11, 19 61
Application for plugging filed November 2, 19 61
Application for plugging approved November 2, 19 61
Plugging commenced November 2, 19 61
Plugging completed November 2, 19 61

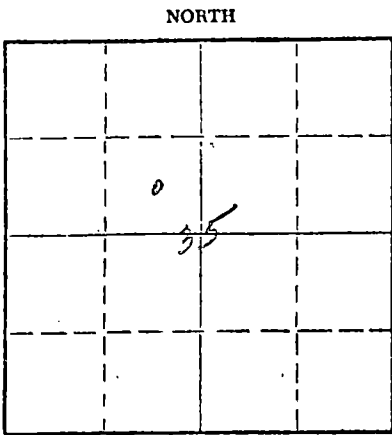

Locate well correctly on above Section Plat

Reason for abandonment of well or producing formation

If a producing well is abandoned, date of last production 19

Was permission obtained from the Conservation Division or its agents before plugging was commenced? YES

Name of Conservation Agent who supervised plugging of this well W. L. Lackamp

Producing formation Depth to top Bottom Total Depth of Well 4800 Feet

Show depth and thickness of all water, oil and gas formations.

OIL, GAS OR WATER RECORDS

CASING RECORD

FORMATION	CONTENT	FROM	TO	SIZE	PUT IN	PULLED OUT
				8 5/8"	363'	
				4 1/2"	4766'	

Describe in detail the manner in which the well was plugged, indicating where the mud fluid was placed and the method or methods used in introducing it into the hole. If cement or other plugs were used, state the character of same and depth placed, from feet to feet for each plug set.

363' of 8 5/8" surface casing
Hole was sanded to 4400' with 5 sacks cement dumped on sand.
Hole mudded to 350'. Rock bridge set from 350' to 340'.
20 sacks cement dumped on bridge. Mud to 40'. Rock bridge
from 40' to 30'. Cement dumped to base of cellar.

3-8-68
RECORDED
NOV 8 1968
STATE CORPORATION COMMISSION
WICHITA, KANSAS

(If additional description is necessary, use BACK of this sheet)

Name of Plugging Contractor Knight Casing Pulling Company
Address Box 405 Chase, Kansas

STATE OF KANSAS, COUNTY OF RICE, ss.

(employee of owner) or (owner or operator) of the above-described well, being first duly sworn on oath, says: That I have knowledge of the facts, statements, and matters herein contained and the log of the above-described well as filed and that the same are true and correct. So help me God.

(Signature) Hall Knight
Chase, Kansas
(Address)

SUBSCRIBED AND SWORN TO before me this 26th day of February, 19 66

My commission expires May 20, 1968

Melton J. Volin
Notary Public.

REPUBLIC NATURAL GAS COMPANY
Hugoton, Kansas
August 30, 1961

Source: Driller's Log

Well: Shrewder #1

Location: 35-32-23

County: Clark

Elevation: 2041 DF
Temp. Abandoned

Company: Republic Natural Gas Company

Contractor: Gabbert and Jones

Drilling Com: April 26, 1961

Rig Released: May 11, 1961

Casing Record: 8-5/8" @ 363' w/275 sx.
4-1/2" @ 4766' w/180 sx.

<u>FORMATION</u>	<u>TOPS</u>	<u>BOTTOM</u>
Clay	0	80
Redrock	80	200
Shale, Shells and Redrock	200	371
Shale	371	527
Shale and Lime	527	1400
Shale and Shells	1400	1830
Shale and Lime	1830	2306
Lime	2306	2826
Lime and Shale	2826	3685
Shale and Shells	3685	3885
Lime and Shale	3885	4371
Lime	4371	4800 T.D.

GEOLOGICAL TOPS:

Heebner	4213
Lansing	4415
Lansing L ₁	4697
Lansing L ₂	4729

RECEIVED
STATE CORPORATION COMMISSION

NOV 9 1961 11-9-61
CONSERVATION DIRECTOR
Wichita, Kansas