

see

15-007-00130-0000

STATE OF KANSAS
STATE CORPORATION COMMISSION


WELL PLUGGING RECORD

Give All Information Completely
Make Required Affidavit
Mail or Deliver Report to:
Conservation Division
State Corporation Commission
800 Bittling Building
Wichita, Kansas

Barber County. Sec. 23 Twp. 32 Rge. (E) 12 (W)

Location as "NE/CNW/SW" or footage from lines NW/4 SW/4 NE/4
Lease Owner Skelly Oil Company
Lease Name G. L. Bloom Well No. 1
Office Address Box 1650, Tulsa, Oklahoma
Character of Well (completed as Oil, Gas or Dry Hole) Dry Hole
Date well completed October 6, 19 55
Application for plugging filed October 6, 19 55
Application for plugging approved October 7, 19 55
Plugging commenced October 28, 19 55
Plugging completed October 28, 19 55
Reason for abandonment of well or producing formation Dry Hole

NORTH

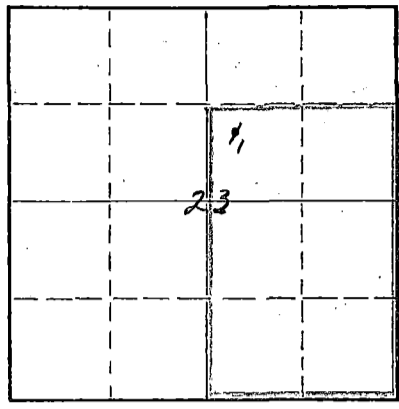

Locate well correctly on above Section Plat

If a producing well is abandoned, date of last production 19
Was permission obtained from the Conservation Division or its agents before plugging was commenced? Yes, Mr. M. A. Rives

Name of Conservation Agent who supervised plugging of this well
Producing formation Depth to top Bottom Total Depth of Well 4758 Feet
Show depth and thickness of all water, oil and gas formations.

OIL, GAS OR WATER RECORDS

CASING RECORD

FORMATION	CONTENT	FROM	TO	OD SIZE	PUT IN	PULLED OUT
Simpson Sand	dry	4700'	4758'	8-5/8"	438' 0"	None
				5-1/2"	4795' 6"	3584' 0"

Describe in detail the manner in which the well was plugged, indicating where the mud fluid was placed and the method or methods used in introducing it into the hole. If cement or other plugs were used, state the character of same and depth placed, from feet to feet for each plug set.

- Bridging plug 4676 1/2'
- Bridging plug 4352'
- 1/2 sack of Cal Seal 4352' to 4349'
- Sand 4349' to 4320'
- 5 sacks of cement 4320' to 4285'
- Mud laden fluid 4285' to 300'
- Rock 300' to 290'
- 20 sacks of cement 290' to 220'
- Mud laden fluid 220' to 35'
- 10 sacks of cement 35' to 6'
- Surface soil 6' to 0'

(If additional description is necessary, use BACK of this sheet)

11-10-55

Name of Plugging Contractor West Supply Co., Inc.
Address Box 506, Chase, Kansas

STATE OF Kansas, COUNTY OF Reno, ss.
H. E. Wamsley (employee of owner) of the above-described well, being first duly sworn on oath, says: That I have knowledge of the facts, statements, and matters herein contained and the log of the above-described well as filed and that the same are true and correct. So help me God.

(Signature) [Signature]
Box 391, Hutchinson, Kansas (Address)

SUBSCRIBED AND SWORN to before me this 9th day of November, 1955

My commission expires April 7, 1959

[Signature] Notary Public.

