

15-007-20210-0000


STATE OF KANSAS
STATE CORPORATION COMMISSION

Form CP-4

WELL PLUGGING RECORD

Give All Information Completely
Make Required Affidavit
Mail or Deliver Report to:
Conservation Division
State Corporation Commission
P. O. Box 17027
Wichita, Kansas 67217
NORTH

Barber County. Sec. 23 Twp. 32S Rge. 12 (E)W (W)
Location as "NE/CNWSW%" or footage from lines SE SW
Lease Owner Beacon Resources Corporation
Lease Name Bloom Well No. 1
Office Address 1000 Century Plaza Bldg., Wichita, Kansas 67202
Character of Well (completed as Oil, Gas or Dry Hole) Dry Hole
Date well completed 10-10 19 72
Application for plugging filed 10-10 19 72
Application for plugging approved 10-10 19 72
Plugging commenced 10-10 19 72
Plugging completed 10-10 19 72
Reason for abandonment of well or producing formation Dry Hole

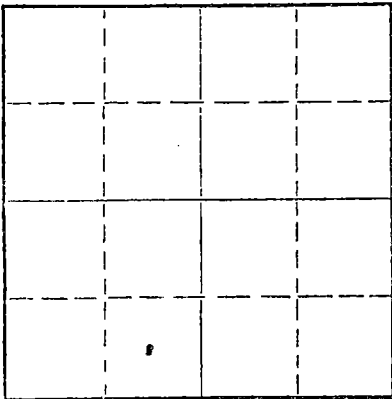

Locate well correctly on above
Section Plat

If a producing well is abandoned, date of last production 19
Was permission obtained from the Conservation Division or its agents before plugging was commenced? Yes

Name of Conservation Agent who supervised plugging of this well Russ Beiberstein
Producing formation _____ Depth to top _____ Bottom _____ Total Depth of Well _____ Feet
Show depth and thickness of all water, oil and gas formations.

OIL, GAS OR WATER RECORDS

CASING RECORD

FORMATION	CONTENT	FROM	TO	SIZE	PUT IN	PULLED OUT
Surface pipe		-0-	263	8 5/8"	263	None

Describe in detail the manner in which the well was plugged, indicating where the mud fluid was placed and the method or methods used in introducing it into the hole. If cement or other plugs were used, state the character of same and depth placed, from _____ feet to _____ feet for each plug set.

- Filled hole with heavy mud.
- #1 plug set @ 240' with 35 sks. cement.
- #2 plug set @ 40' with 15 sks. cement.
- #3 plug set in rat hole with 2 sks. cement.

RECEIVED
STATE CORPORATION COMMISSION
OCT 12 1972
CONSERVATION DIVISION
Wichita, Kansas


(If additional description is necessary, use BACK of this sheet)
Name of Plugging Contractor Sweetman Drilling, Inc.
Address Box 645, Great Bend, Kansas 67530

STATE OF Kansas, COUNTY OF Barton, ss.
Gary L. Hawk (employee of owner) or (owner or operator) of the above-described

well, being first duly sworn on oath, says: That I have knowledge of the facts, statements, and matters herein contained and the log of the above described well as filed and that the same are true and correct. So help me God.

(Signature) Gary L. Hawk
Box 645, Great Bend, Kansas 67530
(Address)

Subscribed and Sworn to before me this 10th day of October, 1972

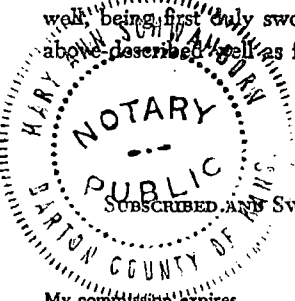

Mary Ann Schwaborn
Notary Public.

My commission expires

7-10-73

WELL LOG
Bloom. #1
SE. SW 23-32S-12W
Barber County, Kansas

Name of Operator: Beacon Resources Corporation
1000 Century Plaza Bldg.
Wichita, Kansas 67202

Date Completed: October 10, 1972

<u>FROM</u>	<u>TO</u>	
0	950	Red bed and shale
950	1590	Shale
1590	3830	Lime and shale
3830	4690	Lime
4690	4710	Simpson sand
4710		Total Depth

RECEIVED
STATE CORPORATION COMMISSION
OCT 12 1972
CONSERVATION DIVISION
Wichita, Kansas

STATE OF KANSAS
COUNTY OF BARTON ss

Gary L. Hawk, Secretary of Sweetman Drilling, Inc., being first duly sworn on oath says: That I have knowledge of the facts, statements and matters herein contained and the log of the above described well as filed and that the same are true and correct.

Gary L. Hawk

Gary L. Hawk

Subscribed and sworn before me this 10th day of October, 1972.

Mary Ann Schwaborn

Notary Public Barton County

My Commission Expires 7-10-73

