

Give All Information Completely
Make Required Affidavit.
Mail or Deliver Report to:
Conservation Division
State Corporation Commission
211 No. Broadway
Wichita, Kansas

WELL PLUGGING RECORD

BARBER County. Sec. 23 Twp. 32S Rge. 12W (E) (W)

Location as "NE/CNW/SW" or footage from lines NE SW NW

Lease Owner MALLONEE-MAHONEY, INC.

Lease Name BLOOM Well No. 1

Office Address BOX 1507, LIBERAL, KS. 67901

Character of Well (completed as Oil, Gas or Dry Hole) DRY HOLE

Date well completed _____ 19__

Application for plugging filed 6/21/1976

Application for plugging approved 6/21/1976


Plugging commenced 6/22/1976

Plugging completed 6/22/1976

Reason for abandonment of well or producing formation _____

If a producing well is abandoned, date of last production _____ 19__

Was permission obtained from the Conservation Division or its agents before plugging was commenced? YES

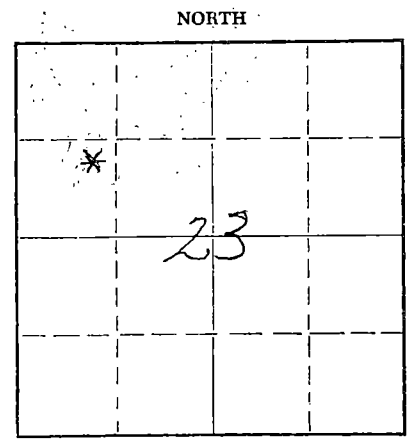

Locate well correctly on above Section Plat

Name of Conservation Agent who supervised plugging of this well BEAVERSCHMIDT

Producing formation _____ Depth to top _____ Bottom _____ Total Depth of Well 4742' Feet

Show depth and thickness of all water, oil and gas formations.

OIL, GAS OR WATER RECORDS

CASING RECORD

FORMATION	CONTENT	FROM	TO	SIZE	PUT IN	PULLED OUT

Describe in detail the manner in which the well was plugged, indicating where the mud fluid was placed and the method or methods used in introducing it into the hole. If cement or other plugs were used, state the character of same and depth placed, from _____ feet to _____ feet for each plug set.

50 SX COMMON @ 250'

25 SX COMMON @ 40'

5 SX COMMON RAT HOLE

RECEIVED
STATE CORPORATION COMMISSION
6-24-76
JUL 24 1976

Name of Plugging Contractor GABBERT-JONES, INC.
Address WICHITA, KS. 67202

STATE OF KANSAS, COUNTY OF SEWARD, ss.
B. A. CLIFFT (employee of owner) or (owner or operator) of the above-described


well, being first duly sworn on oath, says: That I have knowledge of the facts, statements, and matters herein contained and the log of the above described well as filed and that the same are true and correct. So help me God.

(Signature) *B. A. Clifft*

Box 1507, LIBERAL, KS. 67901 (Address)

SUBSCRIBED AND SWORN to before me this 22ND day of JUNE, 1976

Patricia A. Pennington
PATRICIA A. PENNINGTON Notary Public.

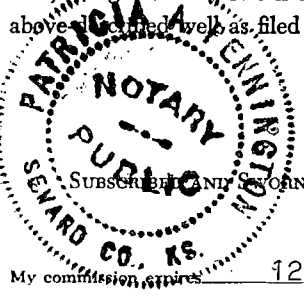

GABBERT-JONES, INC.
WICHITA, KANSAS
DRILLERS' WELL LOG

Bloom #1
NE-SW-1/4 Sec 23-328-12W
Barber County Kansas

Commenced: 4-10-76

Completed: 6-22-76

OPERATOR: MAHONEY DRILLING CO. & MALLONEE-MAHONEY, INC.

Depth		Formation	Remarks
From	to		
0	30	Surface Clay	Run 6 jts of 30' 10 3/4" csg set @ 267' Cemented w/ 350 sls Common w/3% CC PD @ 12:00 p.m. 6-11-76
30	271	Redbed-Rock	
271	945	Redbed	
945	1790	Shale-Shells	
1790	2365	Line-Shale	
2365	2575	Shale-Line	
2575	2775	Line-Shale	
2775	3155	Shale-Line	
3155	3450	Line	
3450	3743	Shale-Sand	
3743	4749	Line	
	4742 - TD		DRY & ABANDONED

STATE OF KANSAS)
) SS
COUNTY OF SEDGWICK)

I, the undersigned, being duly sworn on oath, state that the above Drillers Log is true and correct to the best of my knowledge and belief and according to the records of this office.

GABBERT-JONES, INC.

James S. Sutton II
JAMES S. SUTTON II

Suscribed and sworn to before me this 30th day of June, 1976.

Elizabeth J. Edwards
ELIZABETH J. EDWARDS-NOTARY PUBLIC

My Commission expires February 6, 1979.

Notary Public Commission

JUN 30 1976

7-6-76

COMM. EXPIRES FEBRUARY 6, 1979
WICHITA, KANSAS

