


STATE OF KANSAS  
STATE CORPORATION COMMISSION

Form CP-4

Give All Information Completely  
Make Required Affidavit  
Mail or Deliver Report to:  
Conservation Division  
State Corporation Commission  
211 No. Broadway  
Wichita, Kansas

WELL PLUGGING RECORD

Stafford County. Sec. 36 Twp. 24 Rge. 14 (E) W (W)

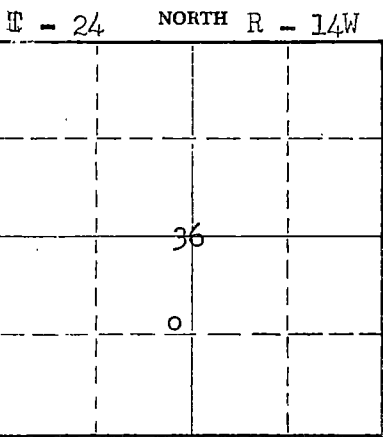

Locate well correctly on above  
Section Plat

Location as "NE/CNW%SW%" or footage from lines SE NE SW  
Lease Owner Frank J. Black  
Lease Name Howell Well No. 1  
Office Address McPherson, Kansas  
Character of Well (completed as Oil, Gas or Dry Hole) Oil  
Date well completed 2-25-61 19  
Application for plugging filed 11-26-63 19  
Application for plugging approved 11-27-63 19  
Plugging commenced 12-30-63 19  
Plugging completed 1-4-64 19  
Reason for abandonment of well or producing formation Depleted.

If a producing well is abandoned, date of last production \_\_\_\_\_ 19  
Was permission obtained from the Conservation Division or its agents before plugging was commenced? yes

Name of Conservation Agent who supervised plugging of this well Archie Elving  
Producing formation \_\_\_\_\_ Depth to top \_\_\_\_\_ Bottom \_\_\_\_\_ Total Depth of Well 4090 Feet  
Show depth and thickness of all water, oil and gas formations.

OIL, GAS OR WATER RECORDS

CASING RECORD

FORMATION	CONTENT	FROM	TO	SIZE	PUT IN	PULLED OUT
				8-5/8"	325'	None
				3-1/2"	4090'	3649'

Describe in detail the manner in which the well was plugged, indicating where the mud fluid was placed and the method or methods used in introducing it into the hole. If cement or other plugs were used, state the character of same and depth placed, from \_\_\_\_\_ feet to \_\_\_\_\_ feet for each plug set.

Checked hole, sanded hole to 4140' and dumped 4 sacks of cement @ 4140' with dump bailer. Pulled 3 1/2" casing, bailed hole to 325', set rock bridge and ran 20 sacks of cement. Mudded hole to 30' and ran 10 sacks of cement to cap well.

PLUGGING COMPLETE.

1-13-1964  
RECEIVED  
STATE CORPORATION COMMISSION

JAN 13 1964

CONSERVATION DIVISION  
Wichita, Kansas

(If additional description is necessary, use BACK of this sheet)  
Name of Plugging Contractor KNIGHT CASING PULLING COMPANY  
Address CHASE, KANSAS

STATE OF KANSAS, COUNTY OF RICE, ss.  
Noel J. Knight (employee of owner) or (owner or operator) of the above-described well, being first duly sworn on oath, says: That I have knowledge of the facts, statements, and matters herein contained and the log of the above-described well as filed and that the same are true and correct. So help me God.

(Signature) Noel J. Knight  
Chase, Kansas  
(Address)

SUBSCRIBED AND SWORN TO before me this 8th day of January, 1964

My commission expires May 20, 1964

Milton J. Volin  
Notary Public.


WELL LOG BUREAU—KANSAS GEOLOGICAL SOCIETY  
508 East Murdock, Wichita, Kansas

Company. HOUSTON PETROLEUM CO. &  
WILKINSON DRILLING, INC.  
Farm. Howell No. 1

SEC. 36 T. 24 R. 14W  
SE NE SW

Total Depth. 4090'  
Comm. 2-11-61 Comp. 2-25-61  
Shot or Treated.  
Contractor. Wilkinson Drilling Inc.  
Issued. 8-11-62

County Stafford  
KANSAS

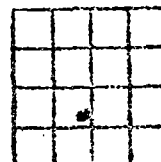

Elevation. 1952' KB

Production. 30 BOED/MISS

CASING:

8 5/8" @ 325' w/250 sks.

Figures Indicate Bottom of Formations.

sand	95
shale & shells	105
shale	329
shale & shells	853
Anhydrite	875
red bed shale shell	1677
lime & shale	3550
shale	3660
lime	3920
shale & lime	4003
chert	4070
shale	4090
TOTAL DEPTH	

TORS: SCOUT

Heebner	3495
Toronto	3514
Douglas	3534
Brown Lime	3633
Lansing	3665
Mississippi	4003

RECEIVED  
STATE CORPORATION COMMISSION

JAN 13 1964

CONSERVATION DIVISION  
Wichita, Kansas