


STATE OF KANSAS
STATE CORPORATION COMMISSION

Give All Information Completely
Make Required Affidavit
Mail or Deliver Report to:
Conservation Division
State Corporation Commission
211 No. Broadway
Wichita, Kansas

WELL PLUGGING RECORD

NORTH

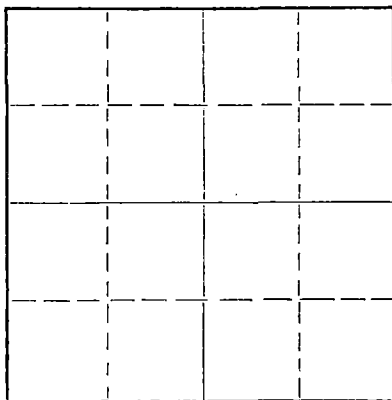

Locate well correctly on above
Section Plat

Stafford County. Sec. 36 Twp. 24 Rge. 14 (E) W (W)
Location as "NE/CNW $\frac{1}{2}$ SW $\frac{1}{2}$ " or footage from lines NW NW NE
Lease Owner Natural Gas and Oil Corp.
Lease Name Mackley #1 Well No. _____
Office Address Great Bend, Kansas
Character of Well (completed as Oil, Gas or Dry Hole) Oil
Date well completed March 15 19 53
Application for plugging filed December 2, 1 19 57
Application for plugging approved December 3, 19 57
Plugging commenced 12-23-57 19 _____
Plugging completed 12-31-57 19 _____
Reason for abandonment of well or producing formation Depleted

If a producing well is abandoned, date of last production November 29, 19 57
Was permission obtained from the Conservation Division or its agents before plugging was commenced? yes

Name of Conservation Agent who supervised plugging of this well Frank Broadfoot
Producing formation Arbuckle Depth to top 4206 Bottom 4220 Total Depth of Well 4260 Feet
Show depth and thickness of all water, oil and gas formations.

OIL, GAS OR WATER RECORDS

CASING RECORD

FORMATION	CONTENT	FROM	TO	SIZE	PUT IN	PULLED OUT
				8-5/8"	221'	none
				5-1/2"	4259'	2960'

Describe in detail the manner in which the well was plugged, indicating where the mud fluid was placed and the method or methods used in introducing it into the hole. If cement or other plugs were used, state the character of same and depth placed, from _____ feet to _____ feet for each plug set.

Checked the hole and found it open.
Filled w/sadn to 4192' and ran 5
sacks of cement. Cement filled to
4149'. Pumped in 18 sacks of gel
mud and pulled 5 1/2" casing. Pumped
in mud and 30 sacks of cement.
Bailed hole to 75', filled with mud
to 35', set a 10' rock bridge and
ran 5 sacks of cement to base of
cellar.

1-2-58

CONSERVATION DIVISION
WICHITA, KANSAS

(If additional description is necessary, use BACK of this sheet)

Name of Plugging Contractor West Supply Co., Inc.
Address Chase, Kansas

STATE OF KANSAS, COUNTY OF RICE, ss.
J. B. Steele, Jr. (employee of owner) or (owner or operator) of the above-described

well, being first duly sworn on oath, says: That I have knowledge of the facts, statements, and matters herein contained and the log of the above-described well as filed and that the same are true and correct. So help me God.

(Signature)


P.O. Box 105, Great Bend, Kansas
(Address)

SUBSCRIBED AND SWORN TO before me this 31 day of December, 19 57

My commission expires

9-27-58

Notary Public.

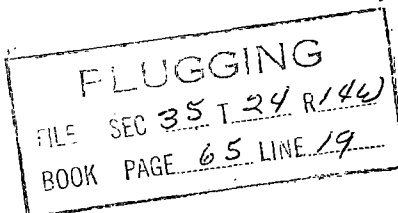

C O P Y

DRILLER'S LOG

COMPANY: Westgate-Greenland Oil Company
 CONTRACTOR: Westgate Drilling Corporation
 FARM: Mackley No. 1 NW NW NE 35-24-14W,
 Stafford County, Kansas, (Old well reopened)
 COMMENCED: March 8, 1953 - Rotary
 March 14, 1953 - Cardwell
 COMPLETED: March 10, 1953 - Rotary
 March 15, 1953 - Cardwell
 ELEVATION: 1945 DF

0 to 115 Cement and wood
 115 to 4260 Washed in
 4260 T.D.

Below are formations shown on Driller's log of M. B. Armer

0 to 221 Sand, shale and shells
 221 to 835 Red bed, shale
 835 to 850 Anhydrite
 850 to 1540 Shale and shells
 1540 to 1890 Lime and shale
 1890 to 2245 Lime
 2245 to 2480 Lime and shale
 2480 to 2600 Lime shells and shale
 2600 to 3135 Lime and shale
 3135 to 3220 Shale
 3220 to 3295 Sand, Lime and shale
 3295 to 3350 Lime and shale
 3350 to 3520 Lime
 3520 to 3605 Lime and shale
 3605 to 3615 Shale
 3615 to 3665 Lime and shale
 3665 to 3855 Lime
 3855 to 4035 Lime and shale
 4035 to 4140 Lime and chert
 4140 to 4260 Lime
 4260 T.D.

221' of 8 5/8" surface originally set by M. B. Armer w/250 sacks cement.

Set 5 1/2" casing at 4259. Cemented with 75 sacks cement.

C E R T I F I C A T E

I, Don Allen, do hereby certify that the above and foregoing is a true and correct copy of the log of the Mackley #1, NW NW NE Section 36-24-14W, Stafford County, Kansas, as reflected by files of the Westgate-Greenland Oil Company.

DON ALLEN /s/

Subscribed and sworn to before me, a Notary Public, within and for Sedgwick County, Kansas, this 20th day of March, 1953.

ESTHER UNSELL/s/

My commission expires May 25, 1953.

RECEIVED
 STATE OF KANSAS

DEC 3 1957

CONSERVATION DIVISION
 Wichita, Kansas

PLUGGING

FILE SEC. 35 T. 24 R. 14W
 BOOK PAGE 65 LINE 19