

STATE CORPORATION COMMISSION

WELL PLUGGING RECORD

Give All Information Completely
Make Required Affidavit
Mail or Deliver Report to:
Conservation Division
State Corporation Commission
212 No. Market
Wichita, Kansas

Kingman County, Sec. 21 Twp. 27S Rge. 8W (E) (W)

Location as "NE/CNW/SW" or footage from lines C NW NE

Lease Owner Leben Drilling, Inc.

Lease Name Dutton Well No. 1

Office Address Box 486, Great Bend, Kansas 67530

Character of Well (completed as Oil, Gas or Dry Hole) Dry Hole

Date well completed 12-1-66 19

Application for plugging filed 12-1-66 19

Application for plugging approved 12-1-66 19


Plugging commenced 12-1-66 19

Plugging completed 12-1-66 19

Reason for abandonment of well or producing formation Dry Hole

If a producing well is abandoned, date of last production 19

Was permission obtained from the Conservation Division or its agents before plugging was commenced? yes

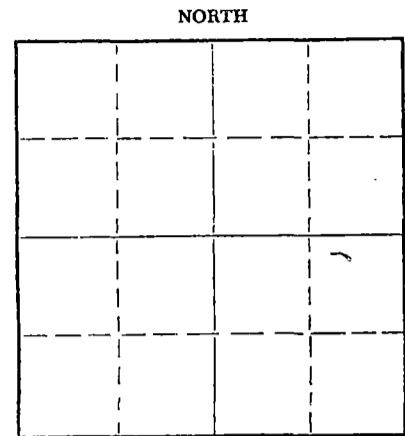

Name of Conservation Agent who supervised plugging of this well Archie Elving

Producing formation Depth to top Bottom Total Depth of Well 4445 Feet

Show depth and thickness of all water, oil and gas formations.

OIL, GAS OR WATER RECORDS

CASING RECORD

Table with 7 columns: FORMATION, CONTENT, FROM, TO, SIZE, PUT IN, PULLED OUT. Row 1: SIZE 8 5/8", PUT IN 210', PULLED OUT none.

Describe in detail the manner in which the well was plugged, indicating where the mud fluid was placed and the method or methods used in introducing it into the hole.

Mudded to 200' - set plug - 25 sacks cement
Mudded to 40' - 1/2 sk. hulls - set plug and 10 sacks cement
Job completed @ 2:45 p.m.

12-8-66

RECEIVED
STATE CORPORATION COMMISSION

DEC 8 1966

CONSERVATION DIVISION
WICHITA, KANSAS

(If additional description is necessary, use BACK of this sheet)

Name of Plugging Contractor Leben Drilling, Inc.
Address Box 486, Great Bend, Kansas 67530

STATE OF KANSAS, COUNTY OF BARTON, ss.
Leslie Kite (employee of owner) or (owner or operator) of the above-described well, being first duly sworn on oath, says: That I have knowledge of the facts, statements, and matters herein contained and the log of the above-described well as filed and that the same are true and correct. So help me God.

(Signature) Leslie Kite

Box 486, Great Bend, Kansas 67530 (Address)

SUBSCRIBED AND SWORN to before me this 7th day of December, 1966

Ulanda Nichols Notary Public.

My commission expires April 1, 1967

DRILLER'S LOG

COMPANY: Leben Drilling, Inc.  
 CONTRACTOR: LEBEN DRILLING, INC.  
 FARM: DUTTON #1  
 LOCATION: C NW NE SEC. 21-27S-8W  
 KINGMAN COUNTY, KANSAS  
 COMMENCED: 11-22-66  
 COMPLETED: 12-1-66

0	85	Sand
85	212	Redbed
212	1235	Shale, Shells
1235	1970	Lime, Shale
1970	3025	Shale, Lime
3025	3215	Lime, Shale
3215	3365	Shale
3365	3780	Lime
3780	3835	Lime, Shale
3835	3965	Lime
3965	4049	Shale, Lime
4049	4100	Mississippi Chat
4100	4150	Chert, Lime
4150	4238	Lime
4238	4300	Shale, Lime
4300	4335	Kinderhook
4335	4403	Viola
4403	4445	Simpson
	<u>4445</u>	<u>RTD - D. &amp; A.</u>

12-8-66  
 RECEIVED  
 STATE CORPORATION COMMISSION  
 DEC 8 1966  
 CONSERVATION DIVISION  
 Wichita, Kansas

8 5/8" used surface casing set @ 210' cemented with 2% cc 175 sacks cement, Common.

I, Leslie Kite, do hereby certify that the above and foregoing is a true and correct copy of the log of the Dutton #1 Well, located C NW NE of Section 21, Township 27 South, Range 8 West, Kingman County, Kansas, as reflected by the records of Leben Drilling, Inc.

Leslie Kite  
 Leslie Kite

STATE OF KANSAS )  
 ) SS  
 COUNTY OF BARTON)

Subscribed and sworn to and before me, a Notary Public, in and for Barton County, Kansas, this 7th day of December, 1966.

Ulanda Nichols  
 Ulanda Nichols

My Commission Expires: April 1, 1967