


STATE OF KANSAS  
STATE CORPORATION COMMISSION

WELL PLUGGING RECORD

Give All Information Completely  
Make Required Affidavit  
Mail or Deliver Report to  
Conservation Division  
State Corporation Comm.  
245 North Water  
Wichita, KS 67202

Kingman County, Sec. 14 Twp. 27S Rge. 8W  
Location as "NE/CNW $\frac{1}{4}$ SW $\frac{1}{4}$ " or footage from lines

C NE SE  
Lease Owner Pintail Petroleum  
Lease Name Peterson Well No. 1  
Office Address 1010 Century Plaza, Wichita, Kansas  
Character of Well (Completed as Oil, Gas or Dry Hole)  
Dry Hole

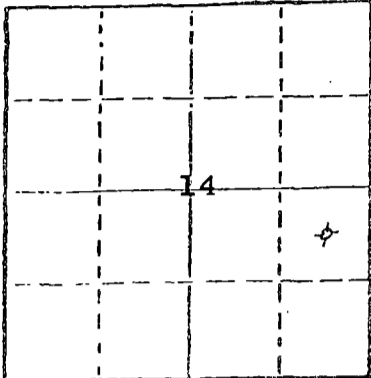

Locate well correctly on above  
Section Plat

Date Well completed January 29, 1979  
Application for plugging filed January 29, 1979  
Application for plugging approved January 29, 1979  
Plugging commenced January 29, 1979  
Plugging completed January 29, 1979  
Reason for abandonment of well or producing formation

Dry Hole  
If a producing well is abandoned, date of last production 19  
Was permission obtained from the Conservation Division or  
its agents before plugging was commenced? Yes

Name of Conservation Agent who supervised plugging of this well Wm. T. Owen  
Producing formation Depth to top Bottom Total Depth of Well 4000'  
Show depth and thickness of all water, oil and gas formations.

OIL, GAS OR WATER RECORDS

CASING RECORD

FORMATION	CONTENT	FROM	TO	SIZE	PUT IN	PULLED OUT
		0'	261'	8-5/8"	254.32'	None

Describe in detail the manner in which the well was plugged, indicating where the mud fluid was placed and the method or methods used in introducing it into the hold. If cement or other plugs were used, state the character of same and depth placed, from feet to feet for each plug set.

Plugged with 40 sacks cement and plug at 240';  
1/2 sack hulls, plug, and 12 sacks cement at  
40'; 3 sacks cement in rat hole.

2-9-79

RECEIVED  
STATE CORPORATION COMMISSION

FEB - 9 1979

(If additional description is necessary, use BACK of COVER sheet)  
Name of Plugging Contractor Allied Cementing Co.

CONSERVATION DIVISION  
Wichita, Kansas

STATE OF KANSAS COUNTY OF SEDGWICK, ss.  
John D. Knightley, Agent (employee of owner) or (owner or operator)  
of the above-described well, being first duly sworn on oath, says: That I have knowledge of  
the facts, statements, and matters herein contained and the log of the above-described well  
as filed and that the same are true and correct. So help me God.


(Signature)

*Stella J. Lipps*  
221 S. Broadway, Wichita, Kansas  
(Address)

SUBSCRIBED AND SWORN TO before me this 7th day of February, 1979

Stella J. Lipps Notary Public.

My commission expires March 12, 1983.

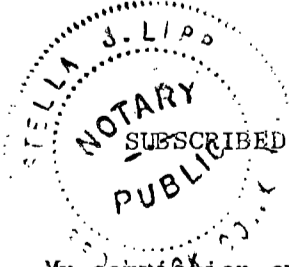

15-095-26808-0000

Pintail Petroleum  
1010 Century Plaza  
Wichita, Kansas 67202

-

Peterson #1  
C NE SE Sec. 14-27S-8W  
Kingman County, Kansas

Contractor: D. R. Lauck Oil Company, Inc.  
221 S. Broadway, Suite 400  
Wichita, Kansas 67202

Commenced: January 22, 1979  
Completed: January 29, 1979

Drillers Log

Sand	40
Red Bed	265
Shale & Red Bed	600
Shale & Salt	1280
Shale & Shells	1825
Shale	2070
Shale & Lime	2330
Shale & Shells	2785
Shale & Lime	2966
Shale & Shells	3265
Lime & Shale	3586
Shale & Lime	3720
Lime & Shale	3820
Lime	4000 RTD

RECEIVED  
STATE CORPORATION COMMISSION

2-9-79

FEB - 9 1979

CONSERVATION DIVISION  
Wichita, Kansas