


15-095-21059-0000

STATE OF KANSAS
STATE CORPORATION COMMISSION

WELL PLUGGING RECORD

Give All Information Completely
Make Required Affidavit
Mail or Deliver Report to
Conservation Division
State Corporation Comm.
245 North Water
Wichita, KS 67202

Kingman County, Sec. 13 Twp. 27S Rge. 8W
Location as "NE/CNW1SW1" or footage from lines
260' S of C SE SW

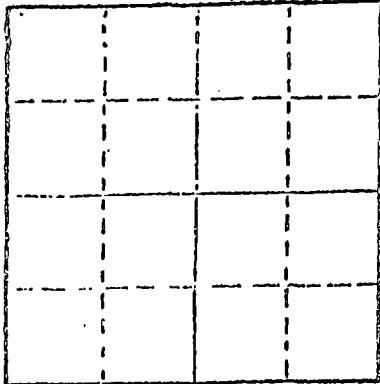

Locate well correctly on above
Section Plat

Lease Owner Hellar Drilling Co., Inc.
Lease Name Nanny Well No. 1
Office Address 711 Petroleum Bldg., Wichita, Kansas 67202
Character of Well (Completed as Oil, Gas or Dry Hole)
Dry hole

Date Well completed March 1, 1981
Application for plugging filed March 1, 1981
Application for plugging approved March 1, 1981
Plugging commenced March 1, 1981
Plugging completed March 11, 1981
Reason for abandonment of well or producing formation
Dry

If a producing well is abandoned, date of last production
19

Was permission obtained from the Conservation Division or
its agents before plugging was commenced? Yes

Name of Conservation Agent who supervised plugging of this well Wm. T. Owen
Producing formation _____ Depth to top _____ Bottom _____ Total Depth of Well _____
Show depth and thickness of all water, oil and gas formations.

OIL, GAS OR WATER RECORDS

CASING RECORD

FORMATION	CONTENT	FROM	TO	SIZE	PUT IN	PULLED OUT

Describe in detail the manner in which the well was plugged, indicating where the mud fluid
was placed and the method or methods used in introducing it into the hold. If cement or other
plugs were used, state the character of same and depth placed, from _____ feet to
_____ feet for each plug set.

Set 1st plug at 250' with 50 sacks cement
Set 2nd plug at 40' with 10 sacks cement
10 sacks in the rat hole

(If additional description is necessary, use BACK of this sheet)

Name of Plugging Contractor _____

RECEIVED
STATE CORPORATION COMMISSION
MARCH 21 1981

STATE OF KANSAS COUNTY OF SEDGWICK, ss.
R. D. Messinger (employee of owner) or (owner or operator)
of the above-described well, being first duly sworn on oath, says that I have knowledge of
the facts, statements, and matters herein contained and the log of the above-described well
as filed and that the same are true and correct. So help me God.

(Signature) R. D. Messinger
422 Union Center, Wichita, Kansas 67202
(Address)

SUBSCRIBED AND SWORN TO before me this 2nd day of March, 19 81

My commission expires 12-24-84

Shirley A. Gallegos
Shirley A. Gallegos Notary Public.



