

STATE OF KANSAS  
STATE CORPORATION COMMISSION


Give All Information Completely  
Make Required Affidavit  
Mail or Deliver Report to:  
Conservation Division  
State Corporation Commission  
800 Bittig Building  
Wichita, Kansas

WELL PLUGGING RECORD

Kingman County, Sec. 8 Twp. 27 Rge. 8 (X) (W)

Location as "NE/CNW/SW" or footage from lines NE NE NE  
Lease Owner Aylward Drilling Company & Aurora Gasoline Co.  
Lease Name Layman Well No. 1  
Office Address 813 First National Bank Bldg. - Wichita, Kansas  
Character of Well (completed as Oil, Gas or Dry Hole) Dry Hole  
Date well completed November 7 19 55  
Application for plugging filed November 7 19 55  
Application for plugging approved November 7 19 55  
Plugging commenced November 7 19 55  
Plugging completed November 7 19 55  
Reason for abandonment of well or producing formation

NORTH

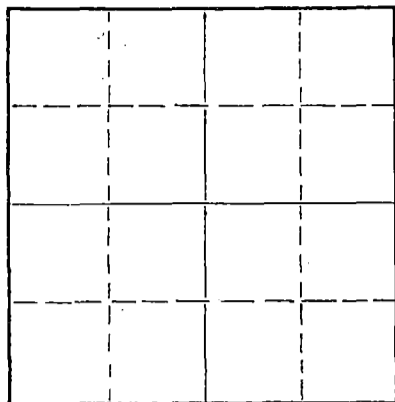

Locate well correctly on above  
Section Plat

If a producing well is abandoned, date of last production 19  
Was permission obtained from the Conservation Division or its agents before plugging was commenced? Yes

Name of Conservation Agent who supervised plugging of this well M. A. Rives - Pratt, Kansas  
Producing formation Depth to top Bottom Total Depth of Well 4491 Feet  
Show depth and thickness of all water, oil and gas formations.

OIL, GAS OR WATER RECORDS

CASING RECORD

FORMATION	CONTENT	FROM	TO	SIZE	PUT IN	PULLED OUT
				8 5/8"	160'	None

Describe in detail the manner in which the well was plugged, indicating where the mud fluid was placed and the method or methods used in introducing it into the hole. If cement or other plugs were used, state the character of same and depth placed, from feet to feet for each plug set.

Filled hole with heavy mud from total depth to 160'; plug from 160' to 95' with 1/2 sack hulls and 20 sacks of cement; mud from 95' to 30'; plug from 30' to surface with 1/2 sack of hulls and 10 sacks of cement.

(If additional description is necessary, use BACK of this sheet)

Name of Plugging Contractor Aylward Drilling Company  
Address 813 First National Bank Bldg., Wichita, Kansas

STATE OF Kansas, COUNTY OF Sedgwick, ss.  
Paul W. Hesse (employee of owner) or (owner or operator) of the above-described

well, being first duly sworn on oath, says: That I have knowledge of the facts, statements, and matters herein contained and the log of the above-described well as filed and that the same are true and correct. So help me God.


(Signature) Paul W. Hesse

813 1st Natl. Bank Bldg., Wichita, Kansas  
(Address)

SUBSCRIBED AND SWORN TO before me this 9th day of November, 19 55

Duane Jessup  
Duane Jessup Notary Public.

My commission expires December 11, 1957

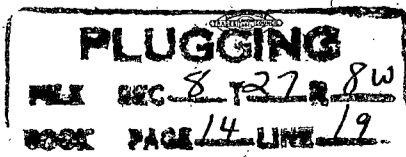

NOV 12 1955 11-12-55

CONSERVATION DIVISION  
Wichita, Kansas

## Casing Record:

8-5/8" - 160' cemented with 135 sacks

Company: Aylward Drilling Co. &  
Aurora Gasoline Co.

Contractor: Aylward Drilling Co.

Elevation: 1644 D.F.

## Location:

NE NE NE  
Sec. 8-27-8W  
Kingman County, KansasCommenced: October 22, 1955  
Completed: November 7, 1955Location:  
NE NE NE  
Sec. 8-27-8W  
Kingman County, Kansas

	<u>From</u>	<u>To</u>	<u>Remarks</u>
Sand	0	85	<u>D.S.T. #1</u> - 3989-4002- Open
Red Rock & Lime	85	105	1 hour. Recovered
Red Rock & Lime Streaks	105	160	100' Heavy Gas Cut
Red Rock & Shale	160	375	Mud & 270' of Salt
Shale & Red Rock	375	460	Water. BHP. 1150# in
Anhydrite	460	470	30 minutes.
Shale & Lime	470	870	
Salt	870	910	<u>D.S.T. #2</u> - 4298-4304- Open 1 hr.
Shale & Lime	910	1220	Recovered 160' Gas
Shale	1220	1235	85' oil & Gas cut Mud
Fort Riley Lime	1235	1380	BHP 280# 30 minutes.
Lime	1380	1560	<u>D.S.T. #3</u> - 4303-09 - Open 1
Shale & Lime	1560	1825	hour. Recovered 15'
Shale	1825	2020	mud BHP o#.
Lime & Shale	2020	2400	
Shale & Shells	2400	2700	<u>D.S.T. #4</u> - 4463-90- Open 1 hour.
Shale & Lime Streaks	2700	2870	945' Salt Water.
Shale & Lime	2870	3525	BHP 1500# 15 minutes.
Lime	2525	3980	
Lime & Chert	3980	4002	
Mississippi Chat	4002	4073	
Lime & Shale	4073	4102	
Shale	4102	4290	
Lime & Shale	4290	4304	
Lime-Cherty	4304	4309	
Lime	4309	4358	
Sand & Shale	4358	4490	R.T.D.

GEOLOGICAL TOPS:

Heebner	3144
Toronto	3154
Douglas Sand	3185
Brown Lime	3342
Lansing K.C.	3358
Mississippi	3988
Kinderhook	4100
Viola	4302
Simpson	4464
Arbuckle	4491
RTD	

I certify that this is a true and correct copy of the above log to the best of my knowledge.

*Paul W. Hesse*  
Paul W. Hesse

Subscribed and sworn to before me this 9<sup>TH</sup> day of NOVEMBER, 1955.

My Commission Expires: December 11, 1957.

