


STATE OF KANSAS
STATE CORPORATION COMMISSION

WELL PLUGGING RECORD

Give All Information Completely
Make Required Affidavit
Mail or Deliver Report to
Conservation Division
State Corporation Comm.
245 North Water
Wichita, KS 67202

Kingman County. Sec. 4 Twp. 27 S Rge. 9 ~~W~~/W
Location as "NE/CNW 1/4 SW 1/4" or footage from lines
C SE SW

Lease Owner The Maurice L. Brown Co.
Lease Name Oak "A" Well No. 1
Office Address 200 Sutton Place Bldg., Wichita, Kans. 67202
Character of Well (Completed as Oil, Gas or Dry Hole)
Dry Hole

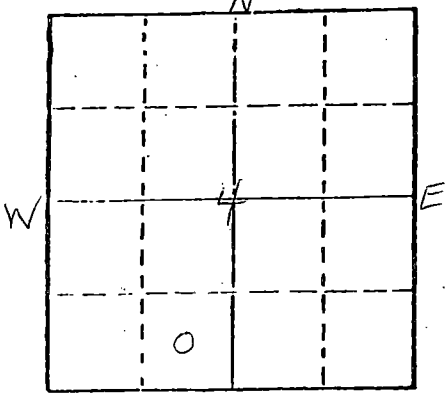

Locate well correctly on above
Section Plat

Date Well completed August 16, 1977
Application for plugging filed (verbally) August 16, 1977
Application for plugging approved (verbally) August 16, 1977
Plugging commenced August 16, 1977
Plugging completed August 16, 1977
Reason for abandonment of well or producing formation
No commercial quantity of oil or gas encountered
If a producing well is abandoned, date of last production
19

Was permission obtained from the Conservation Division or
its agents before plugging was commenced? Yes

Name of Conservation Agent who supervised plugging of this well Bill Owens
Producing formation _____ Depth to top _____ Bottom _____ Total Depth of Well 4435'
Show depth and thickness of all water, oil and gas formations.

OIL, GAS OR WATER RECORDS

CASING RECORD

FORMATION	CONTENT	FROM	TO	SIZE	PUT IN	PULLED OUT

Describe in detail the manner in which the well was plugged, indicating where the mud fluid was placed and the method or methods used in introducing it into the hold. If cement or other plugs were used, state the character of same and depth placed, from _____ feet to _____ feet for each plug set.

Set 1st plug @ 260' with 40 sacks
2nd plug @ 40' with 12 sacks
3rd plug in rathole with 3 sacks

RECEIVED
STATE CORPORATION COMMISSION
8-24-77
AUG 24 1977

Plug was down at 12:00 midnight, August 16, 1977.

CONSERVATION DIVISION
Wichita, Kansas

(If additional description is necessary, use BACK of this sheet)

Name of Plugging Contractor Abercrombie Drilling, Inc.

STATE OF Kansas COUNTY OF Sedgwick, ss.

Jack L. Partridge, Assistant Secretary-Treasurer (employee of owner) or (owner or operator) of the above-described well, being first duly sworn on oath, says: That I have knowledge of the facts, statements, and matters herein contained and the log of the above-described well as filed and that the same are true and correct. So help me God.

(Signature)

Jack L. Partridge


801 Union Center, Wichita, Kansas 67202

(Address)

SUBSCRIBED AND SWORN TO before me this 22nd day of August, 1977

Sandra Richman
Sandra Richman Notary Public.

My commission expires July 21, 1979.

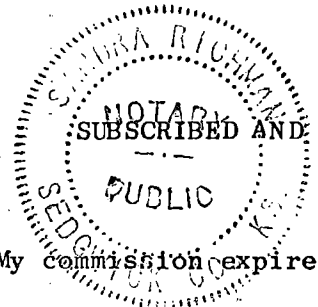

CONTRACTOR'S WELL LOG

OPERATOR: The Maurice L. Brown Co.
 CONTRACTOR: Abercrombie Drilling, Inc.
 WELL NAME: Oak "A" #1
 LOCATION: C SE SW Section 4-27S-9W
 Kingman County, Kansas
 SPUD DATE: August 5, 1977
 COMPLETION DATE: August 16, 1977

0	42	Surface clay & sand
42	220	Sand
220	1771	Shale
1771	2179	Lime & shale
2179	2378	Shale & lime
2378	2714	Lime & shale
2714	3075	Shale & lime
3075	3266	Lime & shale
3266	3470	Shale & lime
3470	3822	Lime & shale
3822	3976	Lime
3976	4233	Lime & shale
4233	4255	Lime
4255	4393	Lime & shale
4393	4435	Shale & lime
	4435	Rotary Total Depth

Spud hole at 10:00 p.m., August 5, 1977. Drilled 270' of 12 1/4" hole, ran 6 joints of 8-5/8" - 24# surface casing. Set at 258.93', cemented with 225 sacks Class "A" Cement, 3% CaCl, 1/4# Floccel per sack. Cement did circulate. Plug was down at 4:00 a.m., August 6, 1977.

T.D. 4435'. Set 1st plug at 260' with 40 sacks, 40' solid bridge with 12 sacks, 3 sacks in the rathole. Plug was down at 12:00 midnight, August 16, 1977. State Plugger - Bill Owens.


RECEIVED
 STATE CORPORATION COMMISSION
 8-24-77
 AUG 24 1977
 CONSERVATION DIVISION
 Wichita, Kansas

STATE OF KANSAS)
) ss
 COUNTY OF SEDGWICK)

Jack L. Partridge, Assistant Secretary-Treasurer of Abercrombie Drilling, Inc., does hereby state that the above and foregoing is a true and correct copy of the log of the Oak "A" #1, C SE SW Section 4-27S-9W, Kingman County, Kansas.

ABERCROMBIE DRILLING, INC.

BY Jack L. Partridge
 Jack L. Partridge,
 Assistant Secretary-Treasurer

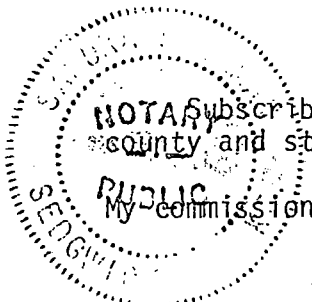

Subscribed and sworn to before me, a Notary Public, in and for the aforesaid county and state as of this 22nd day of August, 1977.

My commission expires July 21, 1979.

Sandra Richman
 Sandra Richman, Notary Public