

WELL PLUGGING RECORD

Give All Information Completely  
Make Required Affidavit  
Mail or Deliver Report to:  
Conservation Division  
State Corporation Commission  
211 No. Broadway  
Wichita, Kansas

KINGMAN County. Sec 27 Twp. 27 Rge. (E)9 (W)

Location as "NE/CNW/SW" or footage from lines C SW NW

Lease Owner PICKRELL DRILLING COMPANY

Lease Name SITTS "C" Well No. 1

Office Address 705 4TH NATIONAL BANK BUILDING, WICHITA, KANSAS

Character of Well (completed as Oil, Gas or Dry Hole) DRY HOLE

Date well completed January 22, 1963

Application for plugging filed January 22, 1963

Application for plugging approved January 22, 1963


Plugging commenced January 22, 1963

Plugging completed January 22, 1963

Reason for abandonment of well or producing formation Dry Hole

If a producing well is abandoned, date of last production 19

Was permission obtained from the Conservation Division or its agents before plugging was commenced? Yes

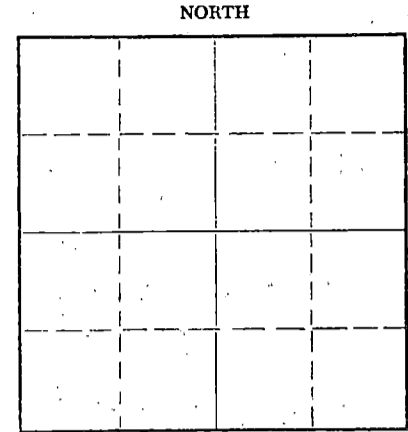

Locate well correctly on above Section Plat

Name of Conservation Agent who supervised plugging of this well Fred Hampel

Producing formation \_\_\_\_\_ Depth to top \_\_\_\_\_ Bottom \_\_\_\_\_ Total Depth of Well 4510 Feet

Show depth and thickness of all water, oil and gas formations.

OIL, GAS OR WATER RECORDS

CASING RECORD

FORMATION	CONTENT	FROM	TO	SIZE	PUT IN	PULLED OUT
				8 5/8	217'	None

Describe in detail the manner in which the well was plugged, indicating where the mud fluid was placed and the method or methods used in introducing it into the hole. If cement or other plugs were used, state the character of same and depth placed, from \_\_\_\_\_ feet to \_\_\_\_\_ feet for each plug set.

Heavy mud to 180'. Set plug. Cemented with  
20 sacks cement. Heavy mud to 40'. Set plug.  
Cemented with 10 sacks cement to bottom of  
cellar. Plugged rat hole with 2 sacks cement.

RECEIVED  
STATE CORPORATION COMMISSION

JAN 28 1963

CONSERVATION DIVISION  
Wichita, Kansas

(If additional description is necessary, use BACK of this sheet)

Name of Plugging Contractor PICKRELL DRILLING COMPANY

Address 705 4th NATIONAL BANK BUILDING, WICHITA, KANSAS

STATE OF KANSAS, COUNTY OF SEDGWICK, ss.

C. W. SEBITS (~~owner or operator~~) of the above-described

well, being first duly sworn on oath, says: That I have knowledge of the facts, statements, and matters herein contained and the log of the above-described well as filed and that the same are true and correct. So help me God.

(Signature) C. W. SEBITS

705 4TH NATL. BANK BLDG, WICHITA, KANSAS

(Address)

SUBSCRIBED AND SWORN to before me this 24th day of JANUARY, 1963

Maxine Blackman  
Maxine Blackman Notary Public.

My commission expires June 21, 1966

ROTARY DRILLING LOG

COMPANY: PICKRELL DRILLING COMPANY Rotary Drilling Commenced 1-8-63  
 705 4th Natl Bk Bldg  
 Wichita, Kansas Rotary Drilling Completed 1-22-63

LOCATION: Sitts "C" No. 1  
 C SW NW 27-27S-9W, Kingman County, Kansas

CONTRACTOR: **PICKRELL DRILLING COMPANY**  
**Wichita, Kansas**

CASING RECORD: (8 jts) 8 5/8" Surface Casing set at 217', cemented with 170 sacks cement. Circulated. Completed 4:00 P.M. on January 8, 1963. No oil string run. D&A.

LOG

(Figures indicate bottom of formation — measurements from top of rotary bushing.)

80	Sand	<u>C.F.S.</u>
217	Red Rock	3998
780	Red Bed & Shale	4008
1265	Shale, Shells & Lime	4071
1475	Shale & Lime	4073
1800	Lime	4278
3434	Lime & Shale	4283
3845	Lime	4288
4008	Lime & Shale	4290
4090	Mississippian	4297
4288	Kinderhook	4375
4353	Viola	4383
4383	Shale & Sand	4470
4440	Simpson	4510
4505	Lime	
4510	TD	<u>Slope Tests</u>
		2500
		3000
		4000
		<u>S.L.M.</u>
		3700
		4105
		4320

RECEIVED  
STATE CORPORATION COMMISSION

JAN 28 1963

CONSERVATION DIVISION  
Wichita, Kansas

The undersigned, C. W. SEBITS, Attorney-in-Fact for PICKRELL DRILLING COMPANY, hereby certifies in behalf of said Company, that the above is a true and correct log of the formation encountered in drilling the above well as reflected by the Daily Drilling Reports.

PICKRELL DRILLING COMPANY

By C. W. SEBITS Attorney-in-Fact

STATE OF KANSAS }  
COUNTY OF SEDGWICK } ss.:

On this 24th day of January, 1963, before me the undersigned, a Notary Public, in and for the County and State aforesaid, personally appeared C. W. SEBITS, to me known to be the identical person who subscribed the name of PICKRELL DRILLING COMPANY to the foregoing instrument as its Attorney-in-Fact and acknowledged to me that he executed the same as his free and voluntary act and deed, and as the free and voluntary act and deed of such company, for the uses and purposes therein set forth.

Given under my hand and seal of office the day and year last above written.

My commission expires: June 21, 1966

Maxine Blackman  
Maxine Blackman Notary Public