

15-095-01017-0000

STATE OF KANSAS
STATE CORPORATION COMMISSION

WELL PLUGGING RECORD

Give All Information Completely
Make Required Affidavit
Mail or Deliver Report to:
Conservation Division
State Corporation Commission
800 Biting Building
Wichita, Kansas

Kingman

County. Sec. 18 Twp. 27 Rge. 9 (E) (W)

Location as "NE/CNW/SW" or footage from lines. NE NE NW

Lease Owner H. H. West

Lease Name McWithey Well No. 1

Office Address 109 1/2 N. Santa Fe, Salina, Kansas

Character of Well (completed as Oil, Gas or Dry Hole) Dry Hole

Date well completed 8-23 1953

Application for plugging filed 8-23 1953

Application for plugging approved 8-23 1953


Plugging commenced 12:00 P.M. 8-23 1953

Plugging completed 2:00 P.M. 8-23 1953

Reason for abandonment of well or producing formation

If a producing well is abandoned, date of last production 19

Was permission obtained from the Conservation Division or its agents before plugging was commenced? Yes

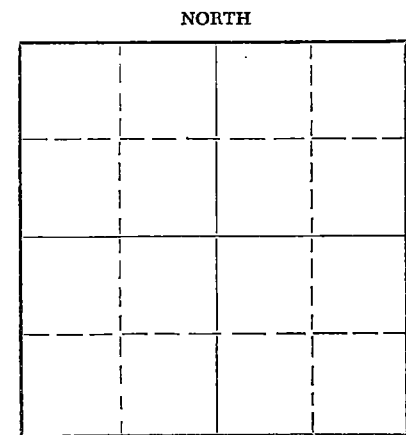

Locate well correctly on above Section Plat

Name of Conservation Agent who supervised plugging of this well Mr. C. D. Stough

Producing formation Depth to top Bottom Total Depth of Well 4511' Feet

Show depth and thickness of all water, oil and gas formations.

OIL, GAS OR WATER RECORDS

CASING RECORD

FORMATION	CONTENT	FROM	TO	SIZE	PUT IN	PULLED OUT
				8-5/8"	347'	

Describe in detail the manner in which the well was plugged, indicating where the mud fluid was placed and the method or methods used in introducing it into the hole. If cement or other plugs were used, state the character of same and depth placed, from feet to feet for each plug set.

Filled hole with heavy mud to 300'. Set Plug and 20 sacks of cement. Filled hole with heavy mud to 35'. Set plug and 10 sacks cement.

RECEIVED 8-28-53
STATE CORPORATION COMMISSION
ADDED 3 1953
CONSERVATION DIVISION
WICHITA, KANSAS

(If additional description is necessary, use BACK of this sheet)
Name of Plugging Contractor Sterling Drilling Company
Address Sterling, Kansas

STATE OF Kansas, COUNTY OF Rice, ss.
Sterling Drilling Company (employee of owner) or (owner or operator) of the above-described well, being first duly sworn on oath, says: That I have knowledge of the facts, statements, and matters herein contained and the log of the above-described well as filed and that the same are true and correct. So help me God.

(Signature) Rollin Mead
Rollin Mead - President
Sterling, Kansas (Address)

SUBSCRIBED AND SWORN TO before me this 26th day of August, 19 53

My Commission Expires Sept. 17, 1953
Notary Public.

24-7968-S 3-53-20M

PLUGGING
FILE SEC 18 TWP 27 R 9 W
BOOK PAGE 124 LINE 20

STERLING DRILLING COMPANY
STERLING, KANSAS

WELL LOG-----MOWITNEY #1

LOCATION: NE NE NW Section 18-27-9 Kingman County, Kansas.

OWNER: H. H. West
CONTRACTOR: Sterling Drilling Company

Commenced: 8-5-53
Completed: 8-23-53

Total Depth: 4511'

LOG

0- 40	Clay
40- 100	Sand
100- 190	Shale & Shells
190- 650	Shale & Red Bed
650-1200	Red Bed, Shale & Salt
1200-1450	Shale & Shells
1450-3360	Lime & Shale
3360-3465	Lime, Sand, & Shale
3465-3865	Lime
3865-4010	Lime & Shale
4010-4025	Lime & Chert
4025-4175	Lime
4175-4290	Shale & Lime
4290-4355	Lime
4355-4390	Lime & Sand
4390-4450	Sand & Shale
4450-4485	Sand Shale & Lime
4485-4511	Lime

CASING RECORD

Ran 347' of 3-5/8" Surface casing.
Cemented with 250 sacks of bulk
cement and 3 sacks of Chloride.

PRODUCTION: Dry and Abandoned .

8-28-53

RECEIVED
STATE CORPORATION COMMISSION

AUG 28 1953

CONSERVATION DIVISION

PLUGGING
FILE SEC 18 T 27 R 9W
BOOK PAGE 124 LINE 20