

STATE OF KANSAS
STATE CORPORATION COMMISSION

WELL PLUGGING RECORD

Give All Information Completely
Make Required Affidavit
Mail or Deliver Report to:
Conservation Division
State Corporation Commission
800 Bittling Building
Wichita, Kansas

STAFFORD

County. Sec. 35 Twp. 24 Rge. 14 (E) W (W)

Location as "NE/CNW/SW" or footage from lines NE SE SW

Lease Owner DEEP ROCK OIL CORPORATION

Lease Name A. C. BOWKER

Well No. 3

Office Address ATLAS LIFE BUILDING, TULSA, OKLAHOMA

Character of Well (completed as Oil, Gas or Dry Hole) DRY HOLE

Date well completed 4-22-55

19

Application for plugging filed PHONE 4-22-55, LETTER 5-2-55

19

Application for plugging approved PHONE 4-22-55, LETTER 4-25-55

19

Plugging commenced 4-22-55

19


Plugging completed 4-22-55

19

Reason for abandonment of well or producing formation

If a producing well is abandoned, date of last production 19

Was permission obtained from the Conservation Division or its agents before plugging was commenced? YES

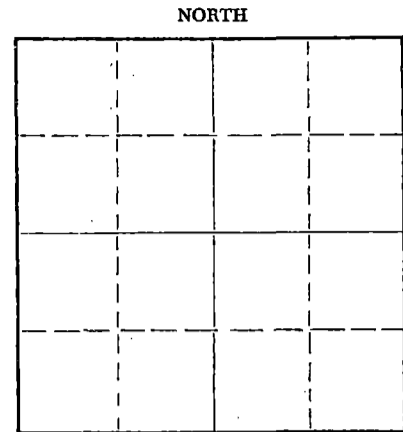

Locate well correctly on above Section Plat

Name of Conservation Agent who supervised plugging of this well WARREN H. HORNER

Producing formation _____ Depth to top _____ Bottom _____ Total Depth of Well 3945 Feet

Show depth and thickness of all water, oil and gas formations.

OIL, GAS OR WATER RECORDS

CASING RECORD

FORMATION	CONTENT	FROM	TO	SIZE	PUT IN	PULLED OUT
				10 3/4	213	NONE

Describe in detail the manner in which the well was plugged, indicating where the mud fluid was placed and the method or methods used in introducing it into the hole. If cement or other plugs were used, state the character of same and depth placed, from _____ feet to _____ feet for each plug set.

FILLED HOLE WITH HEAVY MUD TO 212 FEET. SET PLUG #1 WITH 1/2 SACK HULLS AND 20 SACKS CEMENT. FILLED HOLE WITH HEAVY MUD TO 40 FEET. SET PLUG #2 WITH 1/2 SACK HULLS AND 15 SACKS CEMENT. CEMENTED THROUGH DRILL PIPE.

5-4-55

MAY 1955
CONSERVATION DIVISION
WICHITA, KANSAS

(If additional description is necessary, use BACK of this sheet)

Name of Plugging Contractor GABBERT-JONES DRILLING COMPANY

Address 514 ORPHEUM BUILDING, WICHITA, KANSAS

STATE OF KANSAS, COUNTY OF SEDGWICK, ss.

C. L. GABBERT

(employee of owner) or (owner or operator) of the above-described

well, being first duly sworn on oath, says: That I have knowledge of the facts, statements, and matters herein contained and the log of the above-described well as filed and that the same are true and correct. So help me God.

(Signature)

C. L. Gabbert

WICHITA, KANSAS

(Address)

SUBSCRIBED AND SWORN TO before me this 2ND day of MAY, 19 55

Sumner E. Hall

My commission expires 11-19-58

Notary Public.

PLUGGING
FILE SEC 35 T 24 R 14W
BOOK PAGE 114 LINE 20

GABBERT-JONES DRILLING COMPANY
WICHITA, KANSAS
DRILLERS WELL LOG

A. C. BOWKER #3
NE SE SW, SECTION 35-24-14W
STAFFORD COUNTY, KANSAS
COMMENCED 4-8-55
COMPLETED 4-22-55

DEPTH		FORMATION	REMARKS
FROM	TO		
0	137	SAND	
137	213	SHALE & SHELLS	RAN 213' OF 10 3/4" CASING, CEMENTED W/245 SACKS CEMENT.
213	845	SHALE & SHELLS	
845	850	RED BED	
850	885	ANHYDRITE	
885	1810	SHALE & SHELLS	
1810	2055	LIME	
2055	3060	LIME & SHALE	
3060	3485	LIME	
3485	3695	LIME & SHALE	
3695	3945	LIME	
3945	TD		BRY AND ABANDONED

EXECUTED THIS 30TH DAY OF APRIL, 1955

C. L. Gabbert

STATE OF KANSAS }
COUNTY OF SEDGWICK }

SS

BEFORE ME, THE UNDERSIGNED, A NOTARY PUBLIC, WITHIN AND FOR SAID COUNTY AND STATE, ON THIS 30 DAY OF April, 1955 PERSONALLY APPEARED C. L. Gabbert TO ME PERSONALLY KNOWN TO BE THE IDENTICAL PERSON WHO EXECUTED THE WITHIN AND FOREGOING INSTRUMENT AND ACKNOWLEDGED TO ME THAT HE EXECUTED THE SAME AS HIS FREE AND VOLUNTARY ACT AND DEED FOR THE USES AND PURPOSES THEREIN SET FORTH.

IN WITNESS WHEREOF, I HAVE HEREUNTO SET MY HAND AND OFFICIAL SEAL THE DAY AND YEAR LAST ABOVE WRITTEN.

5-4-55

MAY 4 1955
CONSERVATION DEPARTMENT
WICHITA, KANSAS

MY COMMISSION EXPIRES 11-19-58

Sumner E. Hall
NOTARY PUBLIC

PLUGGING
FILE SEC 35-24-14W
BOOK PAGE 114 LINE 20