


STATE OF KANSAS
STATE CORPORATION COMMISSION

Give All Information Completely
Make Required Affidavit
Mail or Deliver Report to:
Conservation Division
State Corporation Commission
211 No. Broadway
Wichita, Kansas

WELL PLUGGING RECORD

Stafford County, Sec. 32 Twp. 24S Rge. 14 (E) W (W)

Location as "NE/CNW%SW%" or footage from lines NW NW NW
Lease Owner B. E. Ash et al
Lease Name Waters Well No. 1
Office Address Box 211 Ellinwood, Kansas
Character of Well (completed as Oil, Gas or Dry Hole) dry hole
Date well completed June 3 19 57
Application for plugging filed June 4 19 57
Application for plugging approved June 4 19 57
Plugging commenced June 4 19 57
Plugging completed June 4 19 57
Reason for abandonment of well or producing formation _____

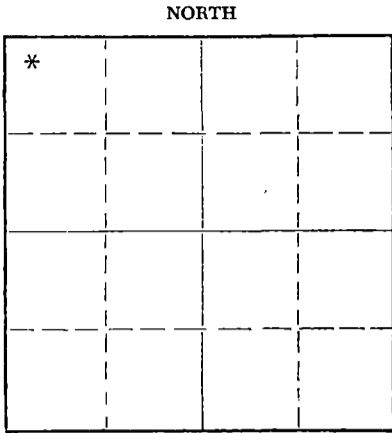

If a producing well is abandoned, date of last production _____ 19 _____
Was permission obtained from the Conservation Division or its agents before plugging was commenced? Yes

Name of Conservation Agent who supervised plugging of this well _____
Producing formation None Depth to top _____ Bottom _____ Total Depth of Well 4405 Feet
Show depth and thickness of all water, oil and gas formations.

OIL, GAS OR WATER RECORDS

CASING RECORD

FORMATION	CONTENT	FROM	TO	SIZE	PUT IN	PULLED OUT
Surface Pipe		-0-	242.36'	8 5/8	242.36'	None

Describe in detail the manner in which the well was plugged, indicating where the mud fluid was placed and the method or methods used in introducing it into the hole. If cement or other plugs were used, state the character of same and depth placed, from _____ feet to _____ feet for each plug set.

Bottom plug at 210'. Dumped 1/3 sack hulls.
Cemented with 20 sacks cement through drill pipe.
Top plug at 20'. Dumped 1/3 sack hulls, 5 sacks cement.

(If additional description is necessary, use BACK of this sheet)
Name of Plugging Contractor Bea Drilling Company
Address Box 211 Ellinwood, Kansas

STATE OF Kansas, COUNTY OF Barton, ss.
B. E. Ash (employee-of-owner) or (owner or operator) of the above-described well, being first duly sworn on oath, says: That I have knowledge of the facts, statements, and matters herein contained and the log of the above-described well as filed and that the same are true and correct. So help me God.

(Signature) B E Ash
Ellinwood, Kansas
(Address)

SUBSCRIBED AND SWORN TO before me this 10th day of June, 19 57

My commission expires 4-27-61

6-13-57

RECEIVED
STATE CORPORATION COMMISSION
Virgil L. McFarland
Notary Public.

PLUGGING
SEC 32 T. 24 R. 14 W
BOOK PAGE 18 LINE 8

STATE CORPORATION COMMISSION
JUN 12 1957
Secretary

W E L L L O G
Waters # 1
NW NW NW 32-24S-14W
Stafford County Kansas

Commenced 5-16-57

Completed

6-3-57

		Elevation	1997 D. F.	2000 K. B.
0 - 35	Clay			
35 - 60	Sand and clay			
60 - 160	Sand and Clay			
160 - 242	Clay	Heebner	3578	(-1578)
242 - 270	Shale	Toronto	3597	(-1597)
270 - 395	Red rock and shale	Douglas	3620	(-1620)
395 - 530	Redbed and shells	Brown lime	3728	(-1728)
530 - 940	Red bed	Lansing Kansas City	3741	(-1741)
940 - 960	Anhydrite	Base Kansas City	4016	(-2016)
960 - 1880	Shale and shells	Conglomerate	4110	(-2110)
1880 - 2100	Sandy lime	Viola	4187	(-2187)
2100 - 2260	Shale and lime	Coarse crystalline		
2260 - 2350	Red rock and lime	viola	4293	(-2293)
2350 - 2420	Red rock and shale	Simpson shale	4320	(-2320)
2420 - 2540	Shale and lime	Simpson sand	4338	(-2338)
2540 - 2610	Lime	Simpson sand	4369	(-2369)
2610 - 2825	Lime and shale	Arbuckle	4372	(-2372)
2825 - 3070	Shale	Rotary T. D.	4405	(-2405)
3070 - 3185	Shale and red rock			
3185 - 3247	Shale and lime			
3247 - 3285	Sandy lime			
3285 - 3365	Shale and lime			
3365 - 3585	Lime			
3585 - 3635	Lime and shale			
3635 - 3725	Lime and chert			
3725 - 3785	Lime and shale			
3785 - 3818	Lime and chert			
3818 - 3985	Lime			
3985 - 4045	Lime and shale			
4045 - 4065	Lime			
4065 - 4175	Lime and shale			
4175 - 4205	Shale, lime and chert			
4205 - 4293	Lime and chert			
4293 - 4360	Lime and shale			
4360 - 4379	Lime			
4379 - 4405	Lime and shale			
4405	T. D.			

240' of 8 5/8" Surface Pipe set.

DST # 1 - 4190' to 4205' - Open 30 minutes. Very weak blow 2 minutes. Recovered 7' mud I.F.P. 15#, F. F. P. 15#, I.B.H.P. 20# in 20 minutes; F.B.H.P. 15# 20 minutes.

Dry and abandoned. Plugged 6-4-57. Bottom plug at 210'. Dumped 1/3 sack hulls. Cemented with 20 sacks cement through drill pipe. Top plug at 20'. Dumped 1/3 sack hulls, 5 sacks cement.

STATE OF KANSAS

COUNTY OF BARTON ss

B. E. Ash, owner of Bea Drilling Company, being first duly sworn on oath says; that I have knowledge of the facts, statements, and matters herein contained and the log of the above described well were as filed and that the same are true and correct.

B. E. Ash
B. E. Ash

Subscribed and sworn before me this 10 day of June, 1957.

6-13-57
W. E. [Signature]
Notary Public

My Commission Expires 4-29-61

PLUGGING		
FILE	SEC <u>32</u>	T. <u>24</u> R. <u>14W</u>
BOOK	PAGE <u>18</u>	LINE <u>8</u>

STATE OF KANSAS
STATE CORPORATION COMMISSION

WELL PLUGGING RECORD

Give All Information Completely
Make Required Affidavit
Mail or Deliver Report to:
Conservation Division
State Corporation Commission
211 No. Broadway
Wichita, Kansas

Stafford County. Sec. 32 Twp. 24S Rge. 14 (E) W (W)

NORTH

*			

Locate well correctly on above
Section Plat

Location as "NE/CNW/SW" or footage from lines. NW NW NW
 Lease Owner B. E. Ash et al
 Lease Name Waters Well No. 1
 Office Address Box 211 Ellinwood, Kansas
 Character of Well (completed as Oil, Gas or Dry Hole) dry hole
 Date well completed June 3 19 57
 Application for plugging filed June 4 19 57
 Application for plugging approved June 4 19 57
 Plugging commenced June 4 19 57
 Plugging completed June 4 19 57
 Reason for abandonment of well or producing formation _____

If a producing well is abandoned, date of last production _____ 19____
 Was permission obtained from the Conservation Division or its agents before plugging was commenced? Yes

Name of Conservation Agent who supervised plugging of this well _____
 Producing formation None Depth to top _____ Bottom _____ Total Depth of Well 4405 Feet
 Show depth and thickness of all water, oil and gas formations.

OIL, GAS OR WATER RECORDS

CASING RECORD

FORMATION	CONTENT	FROM	TO	SIZE	PUT IN	PULLED OUT
Surface Pipe		-0-	242.36'	8 5/8	242.36'	None

Describe in detail the manner in which the well was plugged, indicating where the mud fluid was placed and the method or methods used in introducing it into the hole. If cement or other plugs were used, state the character of same and depth placed, from _____ feet to _____ feet for each plug set.

Bottom plug at 210'. Dumped 1/3 sack hulls.
 Cemented with 20 sacks cement through drill pipe.
 Top plug at 20'. Dumped 1/3 sack hulls, 5 sacks
 cement.

(If additional description is necessary, use BACK of this sheet)
 Name of Plugging Contractor Bea Drilling Company
 Address Box 211 Ellinwood, Kansas

STATE OF Kansas, COUNTY OF Barton, ss.
B. E. Ash (~~employee of owner~~) or (owner or operator) of the above-described well, being first duly sworn on oath, says: That I have knowledge of the facts, statements, and matters herein contained and the log of the above-described well as filed and that the same are true and correct. So help me God.
 (Signature) B E Ash
Ellinwood, Kansas
 (Address)

SUBSCRIBED AND SWORN TO before me this 10th day of June, 1957

My commission expires 4-27-61
RECEIVED
 STATE CORPORATION COMMISSION
 JUN 13 1957 6-13-57
 Notary Public.

CONSERVATION DIVISION
 Wichita, Kansas