


STATE OF KANSAS  
STATE CORPORATION COMMISSION

Form CP-4

WELL PLUGGING RECORD

Give All Information Completely  
Make Required Affidavit  
Mail or Deliver Report to:  
Conservation Division  
State Corporation Commission  
211 No. Broadway  
Wichita, Kansas

Stafford County, Sec. 34 Twp. 24S Rge. (E) 14 (W)  
Location as "NE/CNW%SW%" or footage from lines C NE SW

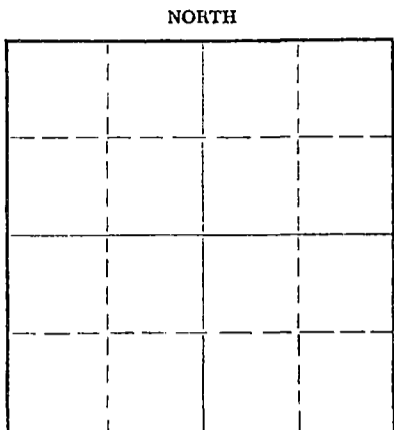

Locate well correctly on above  
Section Plat

Lease Owner Braden Drilling, Inc.  
Lease Name Kachelman Well No. 1  
Office Address 1620 Wichita Plaza, Wichita, Kansas 67202  
Character of Well (completed as Oil, Gas or Dry Hole) Dry Hole  
Date well completed December 28, 1967  
Application for plugging filed December 28, 1967  
Application for plugging approved December 28, 1967  
Plugging commenced December 28, 1967  
Plugging completed 7:00 P.M. December 28, 1967  
Reason for abandonment of well or producing formation Dry Hole

If a producing well is abandoned, date of last production 19  
Was permission obtained from the Conservation Division or its agents before plugging was commenced? Yes

Name of Conservation Agent who supervised plugging of this well \_\_\_\_\_  
Producing formation \_\_\_\_\_ Depth to top \_\_\_\_\_ Bottom \_\_\_\_\_ Total Depth of Well 3754 Feet  
Show depth and thickness of all water, oil and gas formations.

OIL, GAS OR WATER RECORDS

CASING RECORD

FORMATION	CONTENT	FROM	TO	SIZE	PUT IN	PULLED OUT
					JAN 4 1968	

Describe in detail the manner in which the well was plugged, indicating where the mud fluid was placed and the method or methods used in introducing it into the hole. If cement or other plugs were used, state the character of same and depth placed, from \_\_\_\_\_ feet to \_\_\_\_\_ feet for each plug set.

Plugged @ 620' w/25 sacks

Plugged @ 240' w/20 sacks

Plug bridged to hold Kelly w/10 sacks. Cemented to the base of cellar.  
25 sacks in the rat hole.

Job completed 7:00 P.M.

(If additional description is necessary, use BACK of this sheet)

Name of Plugging Contractor Braden Drilling, Inc.  
Address 1620 Wichita Plaza, Wichita, Kansas 67202

STATE OF KANSAS, COUNTY OF SEDGWICK, ss.  
James Tasheff (employee of owner) or (owner or operator) of the above-described well, being first duly sworn on oath, says: That I have knowledge of the facts, statements, and matters herein contained and the log of the above-described well as filed and that the same are true and correct. So help me God.

(Signature) James Tasheff  
James Tasheff  
1620 Wichita Plaza, Wichita, Kansas  
(Address)

SUBSCRIBED AND SWORN TO before me this 3rd day of January, 19 68

My commission expires October 5, 1971

Carol J. Pearson  
Carol J. Pearson Notary Public.

DRILLER'S LOG

#1 KACHELMAN

COMMENCED: December 21, 1967

C NE SW, Sec. 34-24S-14W  
Stafford County, Kansas

COMPLETED: December 28, 1967

Set 250' 12 1/2" hole. Ran 6 jts.  
8-5/8" casing. Set 242.12' @  
248' w/landing joint. Cemented  
w/300 sacks.

Plugged @ 620 w/25 sacks  
Plugged @ 240' w/20 sacks  
Plug bridged to hold Kelly w/10  
sacks. Cemented to base of cellar.  
25 sacks in the rat hole

<u>FORMATION</u>	<u>FROM</u>	<u>TO</u>
Sand	0	140
Shale & Sand	140	175
Shale & Shells	175	250
Red Bed & Blue Shale	250	869
Anhydrite	869	883
Shale	883	990
Shale & Shells	990	1495
Shale & Shells	1495	1743
Shale & Shells	1743	1850
Lime & Shale	1850	2075
Shale & Lime	2075	2273
Shale & Lime	2273	2435
Shale & Lime	2435	2670
Shale & Lime	2670	2850
Shale & Lime	2850	3005
Shale & Lime	3005	3215
Shale & Lime	3215	3360
Shale & Lime	3360	3475
Shale & Lime	3475	3536
Lime & Shale	3536	3680
Lime	3680	3754 T.D.

*Reed*  
1-4-68  
JAN 4 1968

I hereby certify that this is a true and correct log of the above captioned well as shown by the daily drilling reports.

*James Tasheff*  
James Tasheff

Subscribed and sworn to before me this 3rd day of January, 1968.

My commission expires October 5, 1971.

*Carol J. Pearson*  
Carol J. Pearson, Notary Public