


STATE OF KANSAS  
STATE CORPORATION COMMISSION

WELL PLUGGING RECORD

Give All Information Completely  
Make Required Affidavit  
Mail or Deliver Report to:  
Conservation Division  
State Corporation Commission  
211 No. Broadway  
Wichita, Kansas

Stafford County. Sec. 16 Twp. 24 Rge. 14 (E) (W)  
Location as "NE/CNW/SW" or footage from lines SW SW NE  
Lease Owner D. R. Lauck Oil Co., Inc.  
Lease Name Cotton Well No. 1  
Office Address 301 South Broadway Wichita, Kansas  
Character of Well (completed as Oil, Gas or Dry Hole) Oil  
Date well completed August 25 19 56  
Application for plugging filed July 23 19 58  
Application for plugging approved July 28 19 58  
Plugging commenced October 8 19 58  
Plugging completed October 16 19 58  
Reason for abandonment of well or producing formation Production Depleted

NORTH

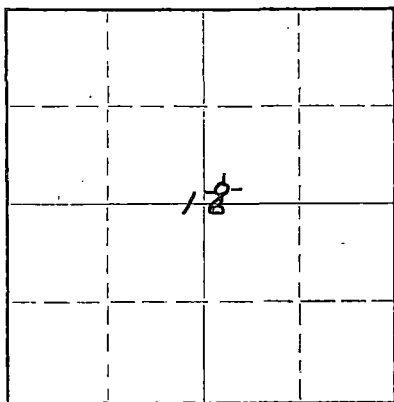

Locate well correctly on above  
Section Plat

If a producing well is abandoned, date of last production June 30 19 58  
Was permission obtained from the Conservation Division or its agents before plugging was commenced? yes

Name of Conservation Agent who supervised plugging of this well Mr. Frank Broadfoot  
Producing formation Arbuckle Depth to top 4312 Bottom 4318 Total Depth of Well 4318 Feet  
Show depth and thickness of all water, oil and gas formations.

OIL, GAS OR WATER RECORDS

CASING RECORD

FORMATION	CONTENT	FROM	TO	SIZE	PUT IN	PULLED OUT
				8 5/8	215	None
				5 1/2	4312	3156
Arbuckle	Oil	4312	4318			

Describe in detail the manner in which the well was plugged, indicating where the mud fluid was placed and the method or methods used in introducing it into the hole. If cement or other plugs were used, state the character of same and depth placed, from \_\_\_\_\_ feet to \_\_\_\_\_ feet for each plug set.

Sand 4318' - 4292'  
4 Sx Cement 4292' - 4268'  
Mud 4268' - 200'  
Rock 200' - 185'  
20 Sx Cement 185' - 125'  
Mud 125' - 30'  
Rock 30' - 20'  
12 Sx Cement 20' - to cellar

RECEIVED  
STATE CORPORATION COMMISSION

NOV 13 1958

CONSERVATION DIVISION  
Wichita, Kansas

(If additional description is necessary, use BACK of this sheet)

Name of Plugging Contractor Wilson, Inc.  
Address Box 254 Stafford, Kansas

STATE OF Kansas, COUNTY OF Sedgwick, ss.  
John H. Knightley (employee of owner) or (owner or operator) of the above-described well, being first duly sworn on oath, says: That I have knowledge of the facts, statements, and matters herein contained and the log of the above-described well as filed and that the same are true and correct. So help me God.

(Signature) John H. Knightley  
Wichita Kansas  
(Address)

SUBSCRIBED AND SWORN TO before me this 12 day of November, 19 58

My commission expires Sept. 14, 1959

Elizabeth Gay  
Notary Public.

PLUGGING  
FILE SEC 16 T. 24 R. 14 W  
BOOK PAGE 118 LINE 1

D. R. Lauck Oil Company, Inc.  
Cotton No.1

SW SW NE  
Sec.16-24S-14W  
Stafford County  
Kansas

Commenced: August 5, 1956  
Completed: August 18, 1956

Casing Record: 215' 8 5/8" cem w/165 sax  
4312' 5 1/2" cem w/125 sax

Elevation: GR 1979; DF 1982; KB 1984

Drillers Log

		Tops	
		Sample	Schlumberger
shale	30		
sand	135	Heebner	3536-1552 3538-1554
shale & shells	215	Douglas	3574-1590 3577-1593
shale, shells & red bed	375	Brown Lime	3679-1695 3682-1698
sand & red bed	560	Lansing Kansas City	3699-1715 3702-1718
red bed & shells	715	Base Kansas City	3960-1976 3962-1978
red bed & shale	915	Mississippian	4085-2101 4088-2104
Anhydrite	940	Kinderhook	4112-2128 4114-2130
shale & shells	1400	Viola	4168-2184 4166-2182
salt & shale	1550	Simpson shale	4258-2274 4260-2276
shale & shells	1765	Arbuckle	4311-2327 4313-2329
lime & shale	2430	Rotary Total Depth	4314-2330 4315-2331
lime	2540		
lime & shale	3520		
lime	3559	DST #1 (M-d)	4086-4100 open 30 min;
lime & shale	3610		weak blow 6 min; recov.
shale	3680		22' mud BHP 0# in 20 "
lime	4015		
shale & lime	4085		
chert	4100		
chert & shale	4200		
chert	4243		
shale & sand	4270		
shale	4311		
Arbuckle	4314		
Rotary TD	4314		

RECEIVED  
STATE CORPORATION

NOV 17 1956

CONSERVATION DEPARTMENT  
Wichita, Kansas

11-13-58

**PLUGGING**  
 FILE SEC. 16 T. 24 R. 14W  
 BOOK PAGE 118 LINE 1