


STATE OF KANSAS
STATE CORPORATION COMMISSION

Form CP-4

Give All Information Completely
Make Required Affidavit
Mail or Deliver Report to:
Conservation Division
State Corporation Commission
211 No. Broadway
Wichita, Kansas

WELL PLUGGING RECORD

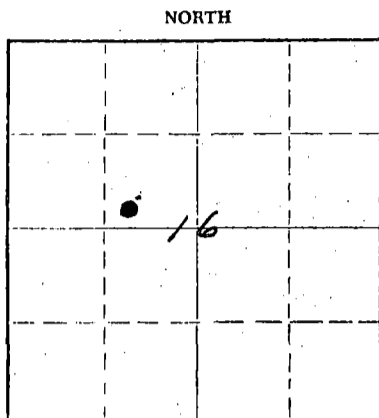

Locate well correctly on above Section Plat

Stafford County, Sec. 16 Twp. 24 Rge. 14 (E) (W)
Location as "NE/CNW/SW" or footage from lines SW SE NW
Lease Owner D. R. Tauck Oil Co., Inc.
Lease Name Thurrow Well No. 3
Office Address 301 So. Broadway Wichita, Kansas
Character of Well (completed as Oil, Gas or Dry Hole) Oil
Date well completed April 1957
Application for plugging filed Sept. 22 1966
Application for plugging approved Sept. 26 1966
Plugging commenced Oct. 1 1966
Plugging completed Oct. 13 1966
Reason for abandonment of well or producing formation well depleted
If a producing well is abandoned, date of last production Sept. 10 1966
Was permission obtained from the Conservation Division or its agents before plugging was commenced? Yes

Name of Conservation Agent who supervised plugging of this well Mr. Archie Elving
Producing formation Arbuckle Depth to top 4306 Bottom 4315 Total Depth of Well 4315 Feet
Show depth and thickness of all water, oil and gas formations.

OIL, GAS OR WATER RECORDS

CASING RECORD

FORMATION	CONTENT	FROM	TO	SIZE	PUT IN	PULLED OUT
Lansing	Dry	3687	4149	8 5/8	207	None
Viola	Dry	4149	4152	5 1/2	4305	2725
Simpson	Dry	4152	4304			
Arbuckle	Oil	4304	4315			

Describe in detail the manner in which the well was plugged, indicating where the mud fluid was placed and the method or methods used in introducing it into the hole. If cement or other plugs were used, state the character of same and depth placed, from _____ feet to _____ feet for each plug set.

Sand 4315 to 4300
5 Sx Cement 4300 to 4270
Mud 4270 to 207
Plug 207
Rock 207 to 195
5 Sx Cement 195- Plug did not hold
Pumped 75 Sx Cement from 225 to base of cellar

RECEIVED
STATE CORPORATION COMMISSION
OCT 25 1966
CONSERVATION DIVISION
WICHITA, KANSAS
10-25-1966

(If additional description is necessary, use BACK of this sheet)

Name of Plugging Contractor Glenn & Smith Pipe Pulling Co.
Address Box 156 Ellinwood, Kansas

STATE OF Kansas, COUNTY OF Barton, ss.
H. E. Wolfe (employee of owner) or (owner or operator) of the above-described well, being first duly sworn on oath, says: That I have knowledge of the facts, statements, and matters herein contained and the log of the above-described well as filed and that the same are true and correct. So help me God.

(Signature) [Signature]
P.O. Box 488 Ellinwood, Kansas
(Address)

SUBSCRIBED AND SWORN TO before me this 21st day of October, 1966

My commission expires June 23, 1970

[Signature]
Notary Public.

D. R. Lauck Oil Company, Inc.

Thurrow #3

SW SE NW Sec.16-24S-14W
Stafford County Kansas

Commenced April 11, 1957

Completed April 25, 1957

Casing Record: 207' 8 5/8" cemented w/165 sacks
4305' 5 1/2" cem.w/ 125 sacks

Elevation: GR 1982; DF 1985; KB 1987

Drillers LogTopsSamples

Shale & clay	50	Anhyddite	925+1062
sand	150	Heebner	3526-1539
shale	207	Brown Lime	3668-1681
shale & shells	395	Lansing KansasCity	3687-1700
red bed & sand	630	Base Kansas City	3950-1963
red bed and shalls	840	Viola	4149-2162
red bed	925	Simpson shale	4252-2265
Anhydrite	950	Arbuckle	4304-2317
shale & shells	1740	Rotary Total Depth	4306-2319
Lime & shale	1910		
Lime	2160		
Lime & shale	3415		
Lime-broken	3500		
Lime	3540		
Lime & shale	3570		
Lime, shale & shells	3625		
shale	3668		
Lime	3974		
shale, lime & chert	4064		
shale & chert	4166		
Lime & chert	4245		
shale & lime	4280		
lime	4306		

RTD 4306

RECEIVED
STATE CORPORATION COMMISSION

SEP 26 1956

CONSERVATION DIVISION
Wichita, Kansas