

STATE OF KANSAS
STATE CORPORATION COMMISSION


Form CP-4

Give All Information Completely
Make Required Affidavit
Mail or Deliver Report to:
Conservation Division
State Corporation Commission
212 No. Market
Wichita, Kansas

WELL PLUGGING RECORD

Stafford County, Sec. 16 Twp. 24S Rge. 14 (E) W (W)
Location as "NE/CNW/SW" or footage from lines NW/4 NW/4 SE/4
Lease Owner Spector Pipe and Supply Inc.
Lease Name Cotton Well No. 1
Office Address Russell, Kansas
Character of Well (completed as Oil, Gas or Dry Hole) _____
Date well completed 7-30-56 19____
Application for plugging filed March 8, 1967 19____
Application for plugging approved March 9, 1967 19____
Plugging commenced March 1, 1967 19____
Plugging completed March 31, 1967 19____
Reason for abandonment of well or producing formation failure to produce profitably

NORTH

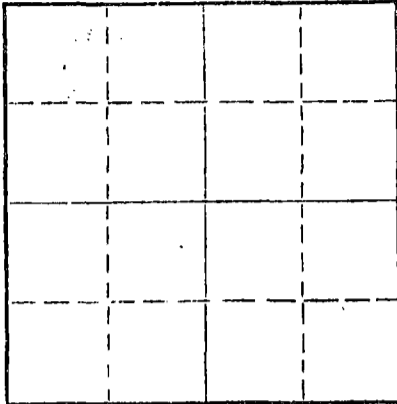

Locate well correctly on above
Section Plat

If a producing well is abandoned, date of last production. _____ 19____
Was permission obtained from the Conservation Division or its agents before plugging was commenced? Yes

Name of Conservation Agent who supervised plugging of this well Archie Elving
Producing formation Arbuckle Depth to top 4303 Bottom 4305 Total Depth of Well 4324 Feet
Show depth and thickness of all water, oil and gas formations.

OIL, GAS OR WATER RECORDS

CASING RECORD

FORMATION	CONTENT	FROM	TO	SIZE	PUT IN	PULLED OUT
				8 5/8" OD	291 ft.	none
				5 1/2" OD	4305 ft.	2007 ft.

Describe in detail the manner in which the well was plugged, indicating where the mud fluid was placed and the method or methods used in introducing it into the hole. If cement or other plugs were used, state the character of same and depth placed, from _____ feet to _____ feet for each plug set.

Plugged back with sand to 3670 feet and dumped 5 sacks of cement.
Set a 20 foot Rock Bridge at 280 feet and dumped 25 sacks of cement.
Mudded hole to 40 feet, set Rock Bridge and dumped 10 sacks of cement.

RECEIVED
STATE CORPORATION COMMISSION

APR 7 1967
4-9-1967
CONSERVATION DIVISION
WICHITA, KANSAS

(If additional description is necessary, use BACK of this sheet)
Name of Plugging Contractor Lynch Casing Pulling Company 457
Address R.F.D. 4, Great Bend, Kansas 67530

STATE OF Kansas, COUNTY OF Russell, ss.
Spector Pipe & Supply, Inc. (employee of owner) or (owner or operator) of the above-described well, being first duly sworn on oath, says: That I have knowledge of the facts, statements, and matters herein contained and the log of the above-described well as filed and that the same are true and correct. So help me God.

(Signature) _____

Russell, Kansas
(Address)

SUBSCRIBED AND SWORN to before me this 5th day of April, 1967

Wilma M. Lindahl
Notary Public.

My commission expires May 21, 1967

WELL LOG BUREAU—KANSAS GEOLOGICAL SOCIETY
503 East Murdock, Wichita, Kansas


COPY

Company- SUMRAY MID-CONTINENT OIL
Farm- H.H. Cotton No. 1

SEC. 16 T. 24 R. 11W
NW NW SE
2260' F3L 2419' FEL SE

Total Depth. 4324'
Comm. 7-18-56 Comp. 7-30-56
Shot or Treated.
Contractor. Stickle Drlg. Co.
Issued. 11-10-56

County Stafford
KANSAS

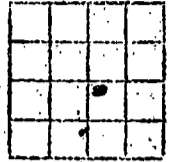

CASING:
8 5/8" 291' w/300 sx cem.
5 1/2" 4305' w/150 sx cem.

Elevation. 1978'

Production. 449 BO

Figures indicate Bottom of Formations.

sand	60
sand-shale	180
shale-shells	480
sand-shale	830
red bed-shale	917
Anhydrite	950
shale-shells	1900
lime-shale	1985
sdv lime-shale	2090
lime	2220
lime-shale	2360
lime	2410
lime-shale	3655
lime	4000
lime-shale	4070
lime w/chert	4125
lime-chert	4163
chart	4205
chert-shale	4223
lime-shale	4306
Arbuckle	4306? RTD
Arbuckle	4324
Total Depth	

Tops:

Lansing Kansas City	3684
Mississippi	4069
Viola	4164
Simpson	4244
Arbuckle	4303

RECEIVED
STATE CORPORATION COMMISSION
MAY 15 1957
CONSERVATION DIVISION
Wichita, Kansas