


STATE OF KANSAS  
STATE CORPORATION COMMISSION

Form CP-4

Give All Information Completely  
Make Required Affidavit  
Mail or Deliver Report to:  
Conservation Division  
State Corporation Commission  
211 No. Broadway  
Wichita, Kansas

WELL PLUGGING RECORD

NORTH

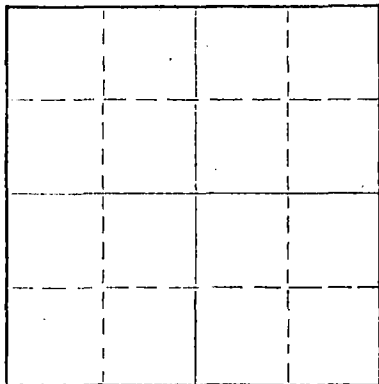

Locate well correctly on above  
Section Plat

Stafford County, Sec. 16 Twp. 21 Rge. (E) 11 (W)  
Location as "NE/CNWxSWx" or footage from lines SW SE SW  
Lease Owner D. R. Lauck Oil Company, Inc.  
Lease Name Smith Well No. 5  
Office Address 301 So. Broadway Wichita, Kansas 67202  
Character of Well (completed as Oil, Gas or Dry Hole) Oil  
Date well completed July 7 19 56  
Application for plugging filed Sept. 22 19 70  
Application for plugging approved Sept. 28 19 70  
Plugging commenced Oct. 1 19 70  
Plugging completed Oct. 16 19 70  
Reason for abandonment of well or producing formation Depleted

If a producing well is abandoned, date of last production August 17 19 70  
Was permission obtained from the Conservation Division or its agents before plugging was commenced? Yes

Name of Conservation Agent who supervised plugging of this well Mr. Russell Beberstein  
Producing formation Arbuckle Depth to top 4276 Bottom 4291 Total Depth of Well 4291 Feet  
Show depth and thickness of all water, oil and gas formations.

OIL, GAS OR WATER RECORDS

CASING RECORD

FORMATION	CONTENT	FROM	TO	SIZE	PUT IN	PULLED OUT
Lansing	Dry	3673	3950	8 5/8	208	None
Arbuckle	Oil	4276	4291	5 1/2	4276	3188

Describe in detail the manner in which the well was plugged, indicating where the mud fluid was placed and the method or methods used in introducing it into the hole. If cement or other plugs were used, state the character of same and depth placed, from \_\_\_\_\_ feet to \_\_\_\_\_ feet for each plug set.

Ran plug to 3775'  
Sand 3775' to 3750'  
5 sacks cement 3750 to 3720  
Pumped 1 sack Hulls, 15 sacks of Jel and 100 sacks  
cement to base of cellar.

RECEIVED  
STATE CORPORATION COMMISSION  
OCT 23 1970  
CONSERVATION DIVISION  
Wichita, Kansas

(If additional description is necessary, use BACK of this sheet)

Name of Plugging Contractor Glenn & Smith Pipe Pulling Company  
Address P. O. Box 156 Ellinwood, Kansas 67526

STATE OF Kansas COUNTY OF Barton, ss.  
H. E. Wolfe (employee of owner) or (owner or operator) of the above-described well, being first duly sworn on oath, says: That I have knowledge of the facts, statements, and matters herein contained and the log of the above-described well as filed and that the same are true and correct. So help me God.

(Signature) *H. E. Wolfe*  
P. O. Box 188 Ellinwood, Kansas 67526  
(Address)

Subscribed and Sworn to before me this 21 day of October, 1970

*Margaret E. Rousch*  
Notary Public.

March 6, 1972



D. R. Lauck Oil Company, Inc.  
and Sunray Mid-Continent Oil Company

Smith #5

SW SE SW Sec.16-24S-14W  
Stafford County Kansas

Commenced: June 19, 1956  
Completed: July 1, 1956

Casing Record: 208' 8 5/8" cem.w/175 sx  
4278' 5 1/2" cem.w/125 sx

Elevation: GR 1974; DF 1976; KB 1978;

Drillers Log

		Tops	
		Sample	Schlumberger
Clay	20	Heebner 3514-1536	3516-1538
Sand	150	Douglas 3554-1576	3554-1576
shale & shells	208	Brown Lime 3658-1680	3659-1681
shale & red bed	375	Lansing KC 3677-1699	3678-1700
sand & shale	435	Base KC 3941-1963	3940-1962
red bed	910	Conglomerate 4089-2111	4082-2104
Anhydrite	935	Viola 4144-2166	4144-2166
shale & shells	1780	Simpson Shale 4222-2244	4220-2242
lime & shale	2750	Arbuckle 4276-2298	4276-2298
shale & shells	2930	Rotary Total Depth	
lime & shale	3780	4279-2301	4279-2301
lime	3965		
lime, shale & chert	4006		
lime & shale	4070		
cherty, shale & lime	4126		
chert	4170		
chert & shale	4200		
shale	4276		
Arbuckle	4279		
rotary Total depth	4279		

RECEIVED  
STATE CORPORATION COMMISSION  
SEP 28 1970  
CONSERVATION DIVISION  
Wichita, Kansas