

STATE OF KANSAS
STATE CORPORATION COMMISSION

WELL PLUGGING RECORD

OR
FORMATION PLUGGING RECORD

Strike out upper line
when reporting plug-
ging off formations.

Give All Information Completely
Make Required Affidavit
Mail or Deliver Report to:
Conservation Division
State Corporation Commission
800 Bitting Building
Wichita, Kansas

Stafford County. Sec. 15 Twp. 24S Rge. 14W (E) (W)
Location as "NE $\frac{1}{4}$ NW $\frac{1}{4}$ SW $\frac{1}{4}$ " or footage from lines 330' from N Line & 990' from E L

Lease Owner The Barnsdall Oil Co.

Lease Name Belle Mathews Well No. 1

Office Address Box 2039, Tulsa, Okla.

Character of Well (completed as Oil, Gas or Dry Hole) Dry Hole

Date well completed August 10th, 1944 19

Application for plugging filed August 10th, 1944 19

Application for plugging approved August 15th, 1944 19

Plugging commenced August 16th, 1944 19

Plugging completed August 21st, 1944 19

Reason for abandonment of well or producing formation Dry Hole

If a producing well is abandoned, date of last production 19

Was permission obtained from the Conservation Division or its agents before plugging was com-
menced? Yes

NORTH

			X

Locate well correctly on above
Section Plat

Name of Conservation Agent who supervised plugging of this well Eldon R. Petty

Producing formation Depth to top Bottom Total Depth of Well 3865 Feet

Show depth and thickness of all water, oil and gas formations.

OIL, GAS OR WATER RECORDS

CASING RECORD


Formation	Content	From	To	Size	Put In	Pulled Out
				10 3/4	159.68'	None
				7"	3680.13'	2236' 6"
				5"	169.92'	None

Describe in detail the manner in which the well was plugged, indicating where the mud fluid was placed and the method or methods used in introducing it into the hold. If cement or other plugs were used, state the character of same and depth placed, from _____ feet to _____ feet for each plug set.

25 Sack cement plug from 3865' to 3670'. Filled with heavy mud from 3670' to 160'
20 Sack cement plug from 160' to 120'. Heavy mud from 120' to 25'. 10 Sack cement
plug from 25' to 5' or bottom of cellar

8-21-1944

PLUGGING
FILE 15-24-14W
BOOK PAGE 127 LINE 42

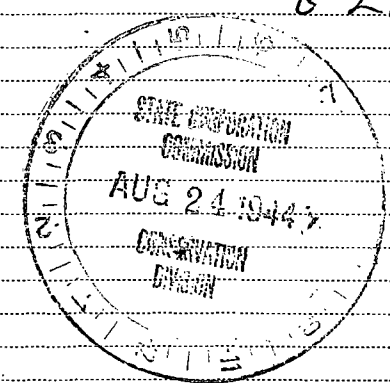

(If additional description is necessary, use BACK of this sheet)

Correspondence regarding this well should be addressed to The Barnsdall Oil Co
Address Box 2039, Tulsa, Okla.

STATE OF Kansas COUNTY OF Reno, ss.
V. A. Knight (employee of owner) or (owner or operator) of the above-described well,

being first duly sworn on oath, says: That I have knowledge of the facts, statements, and matters herein contained and the log of the above-described well as filed and that the same are true and correct. So help me God.

(Signature) V. A. Knight

Box 396, Burrton, Kansas

(Address)

SUBSCRIBED AND SWORN to before me this 23rd day of August 1944, 19

C. J. Franklin
Notary Public.

My commission expires Dec. 15th, 1947

LOG RECORD
BELLE MATHEWS NO.1

LOCATION
330' S of N Line and 330' E of W Line
of the E/2 NE/4 of Sec. 15-24S-14W
Stafford, County, Kansas

CONTRACTOR: Parker Drilling Co.
ROTARY DRILLING COMM: June 16th, 1944
COMP: July 2nd, 1944
STANDARD TOOLS COMM: July 11th, 1944
COMP: Aug. 10th, 1944
PLUGGED AND ABANDONED: Aug. 21st, 1944


INITIAL PRODUCTION:
COMPLETED FOR A DRY HOLE AT A TOTAL DEPTH OF 3865'

CASING RECORD:
10 3/4" OD Mixed Wt. LW & SS Casing set at 159.68' DF - Cemented with 125 Sacks Cement
7" OD 20 & 22# SS Casing set at 3680.13' DF - Cemented with 100 Sacks Cement
5 1/2" OD (Liner) 14# Beth. Gr. H40 Casing set from 3603' to 3773' DF - Cemented with 30 Sack

FORMATION RECORD:					
Surface Sand	0	70	Shale	3000	3022
Sand	70	90	Lime	3022	3060
Shale	90	185	Shale & Lime	3060	3200
Shale & Shells	185	625	Lime	3200	3306
Shale & Redbed	625	850	Lime Broken	3306	3386
Anhydrite	850	900	Lime	3386	3560
Shale & Redbed	900	945	Shale	3560	3660
Lime & Shale	945	1145	Lime	3660	3680
Shale & Shells	1145	1380	Corrected to 3684' RT or 3683' DF		
Salt	1380	1500	CABLE TOOLS		
Shale & Shells	1500	1660	Lime	3683	3688
Shale & Lime	1660	2300	Shale	3688	3690
Lime	2300	2365	Lime	3690	3755
Lime & Shale	2365	2460	Lime with Shale Stringers	3755	3767
Lime	2460	2535	Lime	3767	3842
Lime & Shale	2535	2660	Shale	3842	3848
Lime	2660	2705	Lime	3848	3865
Lime & Shale	2705	2835			
Lime	2835	2915			
Lime & Shale	2915	2965			
Lime	2965	3000			

PLUGGING
FILE 15-24-14W
BOOK PAGE 127 LINE 42

I, V. A. Knight, being first duly sworn, on oath state that I have knowledge of the facts and matter herein set forth and that the same are true and correct.

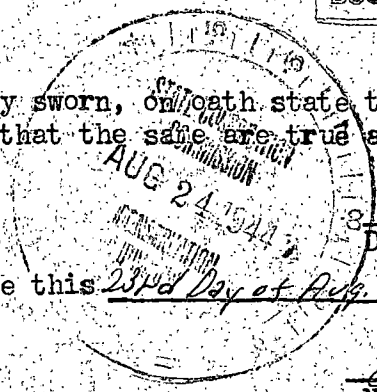

V. A. Knight
Dist. Supt.

Sworn and subscribed to before me this 23rd Day of Aug. 1944.

[Signature]
Notary Public

My commission expires Dec. 15th, 1947